

MISSISSIPPI DEPARTMENT OF NATURAL RESOURCES

Bureau of Land and Water Resources

Southport Mall

P.O. Box 10631

Jackson, Mississippi 39209

WATER WELL DRILLERS LOG

P. River  
F 2037

11/22 1988 Bud Penton & Son Pearl River  
date well completed firm name county well located

LANDOWNER: Jerry Johnson Poplarville Miss.	description of formations encountered	from	to
	white shale	0	108
	gray sand	108	150

(mailing address)

WELL LOCATION:  
sec. 26 T 2 N R 16 E  
(S) (W)  
2 miles W Poplarville  
(distance) (direction) (nearest town)

WELL PURPOSE: none  
(home, irrigation, municipal, industrial)


- WELL COMPLETION DATA:
- (1) diameter (inches) 4"
  - (2) total depth (feet) 150
  - (3) static water level (feet) 85 below above top of ground.
  - (4) casing PVC, 150, (material) (depth)
  - (size) if telescope see back.
  - (5) screen 10, 140 (length) (depth to top)
  - 12, PVC (size) (material)
  - (6) pump 1/2, 80 (HP) (yield gpm)
  - Elect (type power)
  - (7) electric log no (yes or no)
  - (organization running log)
  - (8) how well bottom plugged sand

MISSISSIPPI DEPARTMENT OF NATURAL RESOURCES  
BUREAU OF LAND AND WATER RESOURCES  
JAN 26 1990  
Department of Natural Resources  
Bureau of Land & Water Resources

DRILLERS REMARKS:

If well telescopes please sketch and show depths.

GROUND LEVEL

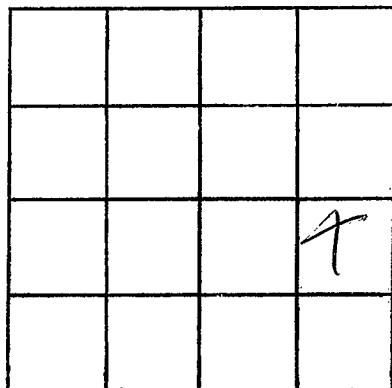

SECTION \_\_\_\_\_

Please indicate well location X.

ADDITIONAL INFORMATION

If more than one screen, show locations of each on sketch.