

MISSISSIPPI DEPARTMENT OF NATURAL RESOURCES

Bureau of Land and Water Resources

Southport Mall

P.O. Box 10631

Jackson, Mississippi 39209

WATER WELL DRILLERS LOG

P. RIVER
F2038

9/11 1989
date well completed

Bud Pentecost
firm name

Pearl River
county well located

LANDOWNER: David Smith

description of formations encountered

from

to

RJ-5 Box 392
poplarville miss
(mailing address)

white shale	0	21
white sand	21	30
blue shale	30	80
white sand	80	142


WELL LOCATION:

sec. 7 T. 2 N. R. 16 E
14 miles NW Poplarville
(distance) (direction) (nearest town)

WELL PURPOSE: home
(home, irrigation, municipal, industrial)

WELL COMPLETION DATA:

- (1) diameter (inches) 4"
- (2) total depth (feet) 142
- (3) static water level (feet) 45 below top of ground.
- (4) casing PVC, 1 1/2" (material) (depth)
- _____ if telescope see back. (size)
- (5) screen 48, 136 (length) (depth to top)
- 1 1/2", PVC (size) (material)
- (6) pump 1, 18 (HP) (yield gpm)
- Elect (type power)
- (7) electric log NO (yes or no)

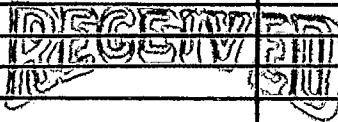

JUN 25 1990

Department of Natural Resources
Bureau of Land & Water Resources


(organization running log)

(8) how well bottom plugged Shore

DRILLERS REMARKS:

If well telescopes please sketch and show depths.

GROUND LEVEL

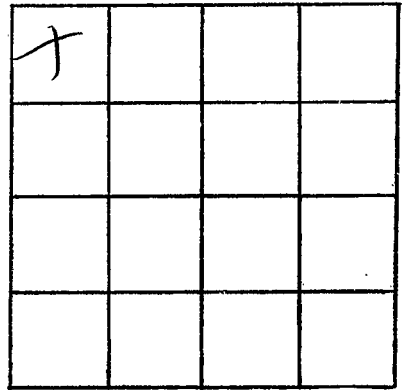

SECTION _____

Please indicate well location X.

ADDITIONAL INFORMATION

If more than one screen,
show locations of each on sketch.