

MISSISSIPPI DEPARTMENT OF NATURAL RESOURCES

Bureau of Land and Water Resources

Southport Mall

P.O. Box 10631

Jackson, Mississippi 39209

WATER WELL DRILLERS LOG

P. RIVER
F 2039

11-23 19 90
date well completed

Boyd Benton
firm name

Pearl River
county well located

LANDOWNER: Robert Felt
Box 26 West
(mailing address)

description of formations encountered	from	to
<u>Red shale</u>	<u>0</u>	<u>10</u>
<u>Red sand</u>	<u>10</u>	<u>60</u>
<u>Blue shale</u>	<u>60</u>	<u>400</u>
<u>Gray sand</u>	<u>400</u>	<u>495</u>

WELL LOCATION:
sec. 35 T. 2 N. R. 16 E
2 miles West Poplarville
(distance) (direction) (nearest town)

WELL PURPOSE: home
(home, irrigation, municipal, industrial)

- WELL COMPLETION DATA:
- (1) diameter (inches) 4
 - (2) total depth (feet) 495
 - (3) static water level (feet) 201 below above top of ground.
 - (4) casing pvc 495
(material) (depth)
 - 4x2 if telescope see back.
(size)
 - (5) screen 10 485
(length) (depth to top)
 - 12 pvc
(size) (material)
 - (6) pump 1 15
(HP) (yield gpm)
 - Elect.
(type power)
 - (7) electric log no
(yes or no)
 - (organization running log)
 - (8) how well bottom plugged Sand
Shrub


RECEIVED
FEB 19 1991

Dept. of Environmental Quality
Bureau of Land & Water Resources

DRILLERS REMARKS:

If well telescopes please sketch and show depths.

GROUND LEVEL

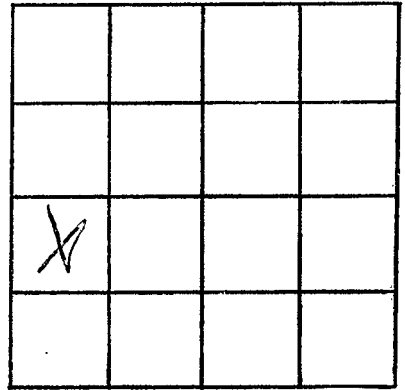

SECTION _____

Please indicate well location X.

ADDITIONAL INFORMATION

If more than one screen,
show locations of each on sketch.