

**MISSISSIPPI DEPARTMENT OF ENVIRONMENTAL  
QUALITY**

Office of Land and Water Resources

P. O. Box 10631  
Jackson, MS 39289-0631  
**WATER WELL DRILLERS LOG**

COUNTY WELL LOCATED <i>Pearl River</i>	
WELL NUMBER <i>F 2044</i>	CODED
DATE WELL COMPLETED <i>8-19-95</i>	

PERMIT NUMBER
NAME OF DRILLING FIRM <i>Boone's Water Well</i>

NAME & MAILING ADDRESS OF LANDOWNER <i>Clara Dodd</i>		
<i>579 S. Lake Woodward Rd.</i>		

WELL LOCATION: SEC	TOWNSHIP	RANGE
<i>2</i>	<i>2</i>	<i>N 16 W</i>

DISTANCE <i>4</i> Miles	DIRECTION <i>NW</i>	NEAREST TOWN <i>Poplarville</i>
----------------------------	------------------------	------------------------------------

OTHER LANDMARK

WELL PURPOSE:  Home Irrigation,  Municipal,  Industrial,  Fish Pond, etc.

PUMP DATA		
PUMP TYPE (Circle One): <input checked="" type="radio"/> Submersible, <input type="radio"/> Turbine, <input type="radio"/> Jet, <input type="radio"/> Flowing Well, Other (Describe) _____		
POWER TYPE (Circle One): <input checked="" type="radio"/> Electric, <input type="radio"/> Tractor, <input type="radio"/> Diesel, <input type="radio"/> Gasoline, <input type="radio"/> Butane, Other (Describe) _____ H/P <i>1</i>		
Pump Capacity (GPM)	No. of Stages	Setting Depth  FT.
PUMP TEST		
Well yielded _____ GPM with a drawdown of _____ ft. after _____ hours of pumping		

WELL DATA		
Well Depth <i>225</i>	Casing Diameter (In.) <i>4</i>	Casing Length (Ft.) <i>205</i>
Type of Casing <i>sch 40</i>	Hole Depth <i>225</i>	Depth to Static Water Level <i>145</i>

TYPE OF COMPLETION: (Circle One or More):  
 Gravel Packed,  Underreamed,  Telescoped,  
 Natural Development,  Open Hole,  Other  
 (Describe) \_\_\_\_\_

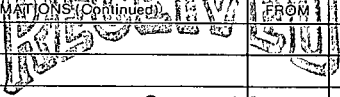
WELL GROUTED TO A DEPTH OF *6* FEET  
 Type Grout (circle one)  Cement,  Bentonite, or Mix

SCREEN DATA		
Diameter - Inches <i>4</i>	Length - Feet <i>20</i>	Slot Size - Inches <i>8</i>
Screen Type <i>sch 40</i>		Depth to Bottom - Feet

LOG DATA	
TYPE OF LOG RUN (Circle One): <input type="radio"/> No Log Run, <input type="radio"/> Electric, <input type="radio"/> Gamma Ray, <input type="radio"/> Density, <input type="radio"/> Sonic, <input type="radio"/> Neutron, Other (Describe) _____	
Name of Organization Running Log	

GEOLOGIC DATA (Office Use Only)			
Surface Elev.	Geologic Unit	Unit Thickness	Depth to Top
Subs. SWL	Date	Analysis	Aquifer Test
Driller's Remarks			
Top of Lap Pipe or Reduction in Casing			
FEET <input type="checkbox"/> IF TELESCOPED OR MORE THAN ONE SCREEN; USE BACK PAGE			

DESCRIPTION OF FORMATIONS ENCOUNTERED	FROM	TO	FORMATIONS (Continued)	FROM	TO
<i>Clay</i>	<i>0</i>	<i>185</i>			
<i>Sand</i>	<i>185</i>	<i>225</i>			

  
**JAN 29 1995**  
 Dept. of Environmental Quality  
 Office of Land & Water Resources

