

Bear River  
93  
1-5-69

MISSISSIPPI  
 BOARD OF WATER COMMISSIONERS  
 416 North State Street  
 Jackson, Mississippi 39201

CODED

CODED

WATER WELL DRILLERS LOG

1-5 19 69 W. S. ... Bear River  
 date well completed firm name county well located

LANDOWNER: Bill Williams  
Ospreyville Miss  
 (mailing address)

description of formations encountered	from	to
<u>SURFACE</u>	<u>0</u>	<u>2</u>
<u>Red Clay</u>	<u>2</u>	<u>21</u>
<u>SAND &amp; CLAY</u>	<u>21</u>	<u>38</u>
<u>Sand</u>	<u>38</u>	<u>47</u>

WELL LOCATION:  
 sec. 6 T 3 N 15 R 15 E  
1 miles S of POP.  
 (distance) (direction) (nearest town)

WELL PURPOSE: 140 W  
 (home, irrigation, municipal, industrial)

- WELL COMPLETION DATA:
- (1) diameter (inches) 2"
  - (2) total depth (feet) 117
  - (3) static water level (feet) 21 below above top of ground.
  - (4) casing PVC 4x  
 (material) (depth)  
2 if telescope see back.  
 (size)
  - (5) screen 4x  
 (length) (depth to top)  
2 (size) PVC (material)
  - (6) pump 1 12  
 (HP) (yield gpm)  
Elec  
 (type power)
  - (7) electric log NO  
 (yes or no)
  - (organization running log)
  - (8) how well bottom plugged BUV

DRILLERS REMARKS:


CODED

FEB 27 1969

MISS. BD. OF  
 WATER COMMISSIONERS

If well telescopes please sketch and show depths.

GROUND LEVEL

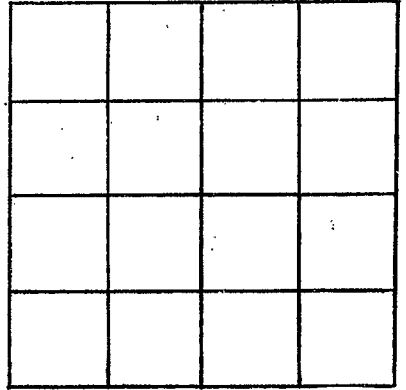

SECTION 6

Please indicate well location X.

ADDITIONAL INFORMATION

If more than one screen, show locations of each on sketch.