

Pearl R.  
 67  
 11-25-74

MISSISSIPPI  
 BOARD OF WATER COMMISSIONERS CODED  
 416 North State Street  
 Jackson, Mississippi 39201

WATER WELL DRILLERS LOG

11-25 date well completed 1974 Paul Hunter & Son firm name Pearl River county well located

LANDOWNER: Alvin C. Mohrenholz  
Peplawville, Miss

description of formations encountered	from	to
Red shale	0	12
White shale	12	60
Blue shale	60	75
White sand & coal	75	95

(mailing address)  
 WELL LOCATION: 15<sup>th</sup> St  
 sec 29 T 2 N R 7 E  
1 miles E of Peplawville  
 (distance) (direction) (nearest town)

WELL PURPOSE: Home  
 (home, irrigation, municipal, industrial)

WELL COMPLETION DATA:

- (1) diameter (inches) 2 in
- (2) total depth (feet) 95
- (3) static water level (feet) 30 below top of ground.
- (4) casing PVC, 85  
 (material) (depth)  
 \_\_\_\_\_ if telescope see back.  
 (size)
- (5) screen 2x5, 85  
 (length) (depth to top)  
2x5 PVC  
 (size) (material)
- (6) pump 3/4, 650  
 (HP) (yield gpm)  
electric  
 (type power)
- (7) electric log NO  
 (yes or no)
- (organization running log)
- (8) how well bottom plugged  
Sand Shale

CODED


RECEIVED

APR - 3 1975

DRILLERS REMARKS:

If well telescopes please sketch and show depths.

GROUND LEVEL

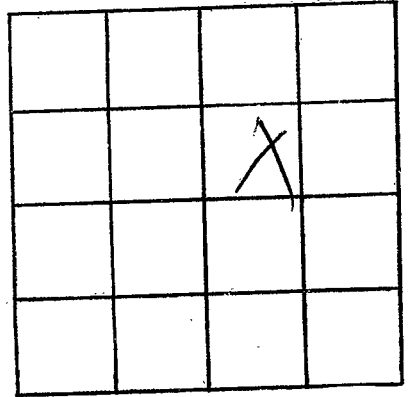

SECTION \_\_\_\_\_

Please indicate well location X.

ADDITIONAL INFORMATION

If more than one screen, show locations of each on sketch.