

Paul Davis
G12
7-20-69

MISSISSIPPI
BOARD OF WATER COMMISSIONERS
416 North State Street
Jackson, Mississippi 39201

CODED

WATER WELL DRILLERS LOG

July 25 1969 *Paul Davis*
date well completed firm name county well located

LANDOWNER: *Edward Smith*
Poplarville
Miss
(mailing address)

description of formations encountered	from	to
<i>Sandstone</i>	<i>0</i>	<i>1</i>
<i>Clay</i>	<i>1</i>	<i>1.5</i>
<i>Sand</i>	<i>1.5</i>	<i>1.7</i>

WELL LOCATION:
sec. 2 T 2 N R 1 E
2 miles E of Poplarville
(distance) (direction) (nearest town)

WELL PURPOSE: *Home*
(home, irrigation, municipal, industrial)

- WELL COMPLETION DATA:
- diameter (inches) 2"
 - total depth (feet) 107
 - static water level (feet) 49 below top of ground.
 - casing PC 102
(material) (depth)
2 if telescope see back.
(size)
 - screen 5' 102
(length) (depth to top)
1 1/2" PC
(size) (material)
 - pump 1 12
(HP) (yield gpm)
PC
(type power)
 - electric log NO
(yes or no)
 - (organization running log)
 - how well bottom plugged NO


JUL 29 1969

MISS. BD. OF
WATER COMMISSIONERS

DRILLERS REMARKS:

If well telescopes please sketch and show depths.

GROUND LEVEL

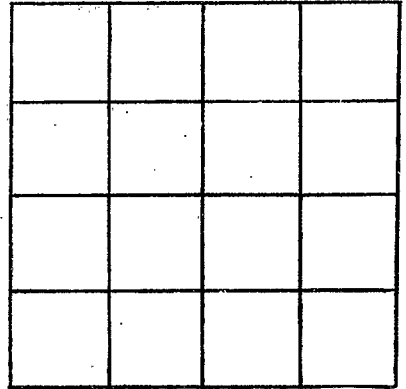

SECTION _____

Please indicate well location X.

ADDITIONAL INFORMATION

If more than one screen, show locations of each on sketch.