

Pearl R,
G-17
3-61

MISSISSIPPI BOARD OF WATER COMMISSIONERS

G-300

WATER WELL DRILLERS LOG

CODED
County Franklin

Date: Mar, 1961, Driller: Leo Lohr
(Name)

(1) Owner of Land: Great Lakes
(Name)
Poplarville Miss
(Address)

(2) Location: 1/4, 1/4, Sec. 29 T2R15,
1 miles east of Poplarville
(distance) (direction) (Nearest Town)

(3) Topography: ✓
(Hilly) (Flat) (Level)

(4) Purpose of Well: _____
(Domestic Irrigation
Municipal, Industrial, Other)

Description & Color of Materials Sand, Clay, Red Clay, Shell, etc.	Thick- ness Feet	Depth Feet
<u>Clay</u>	<u>15</u>	
<u>Sand</u>	<u>15</u>	<u>15-30</u>
<u>White clay</u> (75)	<u>75</u>	<u>75-108</u>
<u>Sand</u>	<u>32</u>	<u>158-190</u>
<u>Clay</u>	<u>70</u>	<u>140-210</u>
<u>Hard stop Clay</u>	<u>17</u>	<u>210-227</u>
<u>Clay - Blue</u>	<u>54</u>	<u>277-331</u>
<u>Blue sand</u>	<u>31</u>	<u>282-313</u>

Information upon completion of well:

(1) Diameter 2 inches.


(2) Total Depth 312 feet.

(3) Water Level 100 feet below top of ground.

(4) Cased to 302, Size 2"

(5) Screen: Size 60 mesh, Length 11"

(6) Were any formations sealed against pollution?
_____ yes, ✓ no.

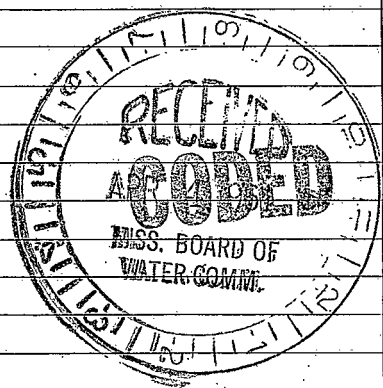

If YES depth of formation _____

Why _____

Drillers Remarks: _____

Well No. 32

(Use Back Side)

15