

G-18
4-61

(?)

WATER WELL DRILLERS LOG

CODED

Date July, 1961, Driller: James Street County Pauline
 887-27 (Name)


(1) Owner of Land:	Description & Color of Materials Sand, Clay, Red Clay, Shell, etc.	Thick- ness Feet	Depth Feet
<u>Emmet Pates</u> (Name)	<u>clay</u>	<u>25</u>	<u>0-25</u>
<u>Poplarville Miss</u> (Address)	<u>sand</u>	<u>2</u>	<u>25-27</u>
(2) Location: <u>1/4</u> , <u>1/4</u> , Sec. <u>19 T2 R5</u>	<u>clay</u>	<u>9.3</u>	<u>27-120</u>
<u>1 1/2</u> miles <u>South</u> of <u>Poplarville</u> (distance) (direction) (Nearest Town)	<u>7 in sand</u>	<u>18</u>	<u>120-138</u>
(3) Topography: <input checked="" type="checkbox"/> (Hilly) <input type="checkbox"/> (Flat) <input type="checkbox"/> (Level)	<u>clay</u>	<u>14.2</u>	<u>138-210</u>
(4) Purpose of Well: <u>Home Use</u> (Domestic Irrigation Municipal, Industrial, Other)	<u>sand</u>	<u>60</u>	<u>210-270</u>

Information upon completion of well:

- (1) Diameter 2 inches.
- (2) Total Depth 340 feet.
- (3) Water Level 98 feet below top of ground.
- (4) Cased to 340, Size 2.
- (5) Screen: Size 0.08, Length 4 ft.
- (6) Were any formations sealed against pollution?
 yes, no.

If YES depth of formation _____
 Why _____
 Drillers Remarks: _____

CODED

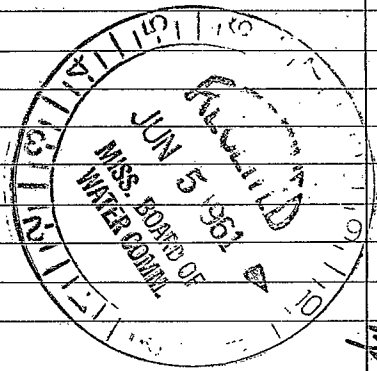

(Use Back Side)

Well No. 15

[The page contains extremely faint and illegible text, likely bleed-through from the reverse side of the document. The text is scattered across the page and cannot be transcribed.]