

Pearl R.  
G-20  
9-20-65

MISSISSIPPI BOARD OF WATER COMMISSIONERS

WATER WELL DRILLERS LOG  
**CODED**

Date: 9-20, 1965, Driller: Neil Lumpkin County P.R.  
157-38 160-17 (Name)

(1) Owner of Land: Walter Ladner  
(Name)  
Poplarville,  
(Address)  
(2) Location: 270 1/4, 1/4, Sec. T 2015  
3 miles East of Poplarville  
(distance) (direction) Hwy 26 (Nearest Town)  
(3) Topography: Flat  
(Hilly) (Flat) (Level)  
(4) Purpose of Well: Domestic  
(Domestic Irrigation  
Municipal, Industrial, Other)


| Description & Color of Materials<br>Sand, Clay, Red Clay, Shell, etc. | Thick-<br>ness<br>Feet | Depth<br>Feet |
|-----------------------------------------------------------------------|------------------------|---------------|
| <u>white + blue clay</u>                                              | <u>0</u>               | <u>100</u>    |
| <u>good sand</u>                                                      | <u>100</u>             | <u>131</u>    |

Information upon completion of well:

(1) Diameter 2 inches.  
(2) Total Depth 131 feet.  
(3) Water Level 80 feet below top of ground.  
(4) Cased to \_\_\_\_\_, Size \_\_\_\_\_  
(5) Screen: Size 2", Length 5'  
(6) Were any formations sealed against pollution?  
\_\_\_\_\_ yes, no no.

If YES depth of formation \_\_\_\_\_  
Why \_\_\_\_\_  
Drillers Remarks: \_\_\_\_\_

**CODED**

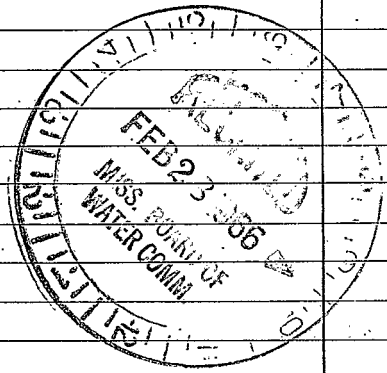

(Use Back Side)

Well No.

