

**PEARL RIVER**  
**G 25**  
**2-2-72**

MISSISSIPPI  
 BOARD OF WATER COMMISSIONERS  
 416 North State Street  
 Jackson, Mississippi 39201

WATER WELL DRILLERS LOG **CODED**

date well completed 2-2 1972 firm name Earl Penton water well ser Pearl R. No 1 county well located \_\_\_\_\_

LANDOWNER:  
Mr. H. L. White  
Poplarville Miss.  
 (mailing address)

WELL LOCATION:  
 sec. 29 T. 2 N. R. 15 E.  
1 miles East of Poplarville  
 (distance) (direction) (nearest town)

WELL PURPOSE: Home  
 (home, irrigation, municipal, industrial)

WELL COMPLETION DATA:

(1) diameter (inches) 4 1/2

(2) total depth (feet) 147

(3) static water level (feet) 91 below above top of ground.

(4) casing Galv. 142  
 (material) (depth)  
2" if telescope see back.  
 (size)

(5) screen 5' 142  
 (length) (depth to top)  
2" S.S.  
 (size) (material)

(6) pump 1 350  
 (HP) (yield gpm)  
Elect.  
 (type power)

(7) electric log NO  
 (yes or no)

(organization running log) \_\_\_\_\_

(8) how well bottom plugged Shoe

description of formations encountered	from	to
Red clay	0	12
wh. f.c. clay	12	61
pink yellow sd.	61	68
white clay	68	94
Blue clay	94	118
med. white sd.	118	135
med. to coarse w. sd.	135	147

**CODED**


JUL 21 1972

MISS. BO. OF  
 WATER COM.

DRILLERS REMARKS:

If well telescopes please sketch and show depths.

GROUND LEVEL

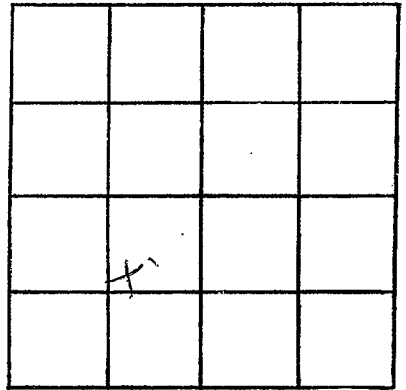

SECTION 29

Please indicate well location X.

ADDITIONAL INFORMATION

If more than one screen, show locations of each on sketch.