

PEARL RIVER  
G 26  
6-13-72

MISSISSIPPI  
 BOARD OF WATER COMMISSIONERS  
 416 North State Street  
 Jackson, Mississippi 39201

**CODED**

WATER WELL DRILLERS LOG

6-13-72 date well completed      Earl Pentecostal water well serv. Pearl River firm name      Pearl River county well located

LANDOWNER:  
Frank Beatty  
Poplarville miss.  
 (mailing address)

description of formations encountered	from	to
<u>Red sd. &amp; Red clay</u>	<u>0</u>	<u>10</u>
<u>Red clay</u>	<u>10</u>	<u>12</u>
<u>Gravel &amp; Co. white sd.</u>	<u>12</u>	<u>55</u>

WELL LOCATION:  
 sec 29 T 2 N R 12 E  
1 miles East of Poplarville  
 (distance) (direction) (nearest town)

WELL PURPOSE: Home  
 (home, irrigation, municipal, industrial)

**CODED**

- WELL COMPLETION DATA:
- (1) diameter (inches) 4 1/2
  - (2) total depth (feet) 55
  - (3) static water level (feet) 22 below top of ground
  - (4) casing P.V.C. (material), 50 (depth)  
2 in. (size) if telescope see back.
  - (5) screen 5' (length), 50 (depth to top)  
2 (size), P.V.C. (material)
  - (6) pump 1 (HP), 550 (yield gpm)  
Elect (type power)
  - (7) electric log NO (yes or no)

(organization running log)

444 91 7972


(8) how well bottom plugged Shoe

MISS. DIV. OF  
 WATER RESOURCES

DRILLERS REMARKS:

If well telescopes please sketch and show depths.

GROUND LEVEL

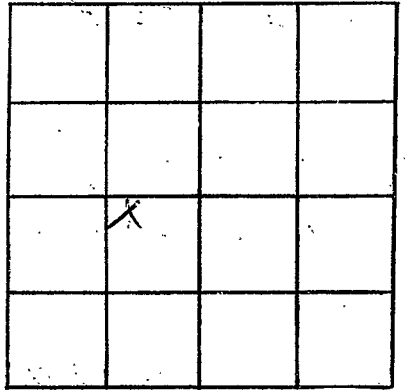

SECTION 29

Please indicate well location X.

ADDITIONAL INFORMATION

If more than one screen, show locations of each on sketch.