

Pearl River
G 27
9-4-72

MISSISSIPPI
 BOARD OF WATER COMMISSIONERS
 416 North State Street
 Jackson, Mississippi 39201

CODED

WATER WELL DRILLERS LOG

9-4 1972 Earl Penton water well serv. Pearl River
 date well completed firm name county well located

LANDOWNER:

Kenneth Perrott
Poplarville miss.
 (mailing address)

description of formations encountered

description of formations encountered	from	to
<u>white & red clay</u>	<u>0</u>	<u>20</u>
<u>blue clay</u>	<u>20</u>	<u>48</u>
<u>no. white sd. & c.v.</u>	<u>48</u>	<u>125</u>

WELL LOCATION:

sec 32 T 2 N R 15 E
2 miles East of Poplarville
 (distance) (direction) (nearest town)

WELL PURPOSE: Home
 (home, irrigation, municipal, industrial)

WELL COMPLETION DATA:

- (1) diameter (inches) 4.5
- (2) total depth (feet) 125
- (3) static water level (feet) 36 below top of ground
- (4) casing Plastic 120
 (material) (depth)
2" if telescope see back.
 (size)
- (5) screen 5' 120
 (length) (depth to top)
2" Plastic
 (size) (material)
- (6) pump 1 430
 (HP) (yield gpm)
Elect
 (type power)
- (7) electric log NO
 (yes or no)

(organization running log)

(8) how well bottom plugged Shoe


DRILLERS REMARKS:

NOV 27 1972

MISS. BD. OF
 WATER COM.

If well telescopes please sketch and show depths.

GROUND LEVEL

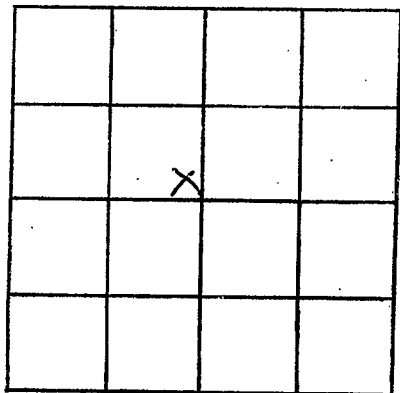

SECTION 22

Please indicate well location X.

ADDITIONAL INFORMATION

If more than one screen,
show locations of each on sketch.