

PEARL RIVER  
G 28  
3-7-72

MISSISSIPPI  
BOARD OF WATER COMMISSIONERS  
416 North State Street  
Jackson, Mississippi 39201

**CODED**

WATER WELL DRILLERS LOG

3-7 1972 Parnell Anderson Pearl River  
date well completed firm name county well located

LANDOWNER: Edward Smith  
Poplarville Miss  
(mailing address)

WELL LOCATION:  
sec. 29 T. 2 N. R. 15 E  
S W  
4 miles E of Poplarville  
(distance) (direction) (nearest town)

WELL PURPOSE: Home  
(home, irrigation, municipal, industrial)

- WELL COMPLETION DATA:
- (1) diameter (inches) 2"
  - (2) total depth (feet) 127
  - (3) static water level (feet) 40 below top of ground.
  - (4) casing Plastic, 122 (material) (depth)
  - (size) If telescope see back.
  - (5) screen 5' 122 (length) (depth to top)  
2" Plastic (size) (material)
  - (6) pump 1 12 (HP) (yield gpm)
  - (type power)
  - (7) electric log (yes or no)
  - (organization running log)
  - (8) how well bottom plugged  
Backwash Valve

description of formations encountered	from	to
top soil	0	3
Red Clay	3	24
Fine Sand	24	36
Red Clay	36	45
Coarse Sand	45	67
Blue Clay	67	105
Fine Sand	105	113
Coarse Sand	113	127


**CODED**

DRILLERS REMARKS:

DEC 11 1972

If well telescopes please sketch and show depths.

GROUND LEVEL

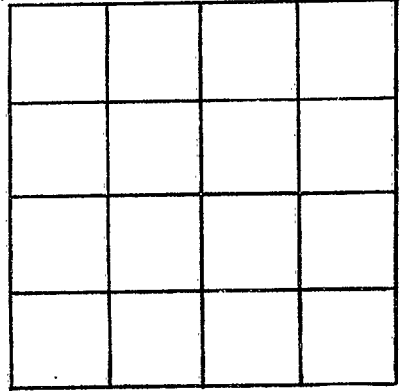

SECTION \_\_\_\_\_

Please indicate well location X.

ADDITIONAL INFORMATION

If more than one screen,  
show locations of each on sketch.