

Pearl River
G 30
6-15-73

MISSISSIPPI
BOARD OF WATER COMMISSIONERS
416 North State Street
Jackson, Mississippi 39201

CODED

WATER WELL DRILLERS LOG

6-15 1973 LUMPKIN Well Ser. Pearl River
date well completed firm name county well located

LANDOWNER: WALTER LADNER

Rr. description of formations encountered from to

POPPLARVILLE, Miss (mailing address) CLAY 0 121 Sand Sand 121 146

WELL LOCATION:

sec. 28 T 2 N R 15 E
1.5 miles W. of POPPLARVILLE
(distance) (direction) (nearest town)

WELL PURPOSE: Home
(home, irrigation, municipal, industrial)

WELL COMPLETION DATA:


- (1) diameter (inches) 2"
- (2) total depth (feet) 146'
- (3) static water level (feet) 40 below above top of ground.
- (4) casing P.V.C., 140',
(material) (depth)
16 if telescope see back.
(size)
- (5) screen 6', 140'
(length) (depth to top)
2", P.V.C.
(size) (material)
- (6) pump 1, 10
(HP) (yield gpm)
Elec.
(type power)
- (7) electric log No
(yes or no)
- (organization running log)
- (8) how well bottom plugged Sand Shale

CODED

DRILLERS REMARKS: JUL 27 1973

If well telescopes please sketch and show depths.

GROUND LEVEL

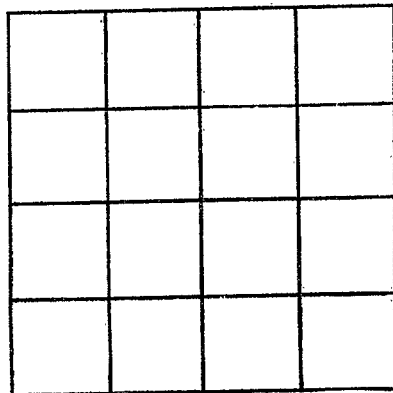

SECTION _____

Please indicate well location X.

ADDITIONAL INFORMATION

If more than one screen,
show locations of each on sketch.