

P. R.  
G 34  
8-18-73

MISSISSIPPI  
BOARD OF WATER COMMISSIONERS CODED

416 North State Street  
Jackson, Mississippi 39201

WATER WELL DRILLERS LOG

*Pearl River*

*8-18* 19*73* *Earl Penton water well sero.*  
date well completed                      firm name                      county well located

LANDOWNER:

*EXXON USA.*  
*Baton Rouge LA.*  
(mailing address)

WELL LOCATION:

sec *28-T-2-N* R *15-E*  
(distance) miles (direction) of (nearest town)

WELL PURPOSE:

*Industrial*  
(home, irrigation, municipal, industrial)

WELL COMPLETION DATA:

- (1) diameter (inches) *8*
- (2) total depth (feet) *292*
- (3) static water level (feet) *53* below  
top of ground.
- (4) casing *P.V.C. 282*  
(material) (depth)  
*4* (size) if telescope see back.
- (5) screen *10' 282*  
(length) (depth to top)  
*4* (size) *P.V.C.* (material)
- (6) pump *3* *1100 H.P.*  
(HP) (yield gpm)  
*Elect* (type power)
- (7) electric log *NO*  
(yes or no)

(organization running log)

(8) how well bottom plugged *Shoe*

description of formations encountered

from to

<i>Red clay</i>	<i>0</i>	<i>20</i>
<i>Blue clay</i>	<i>20</i>	<i>80</i>
<i>Coarse Red sd.</i>	<i>80</i>	<i>150</i>
<i>Blue clay</i>	<i>150</i>	<i>220</i>
<i>Fine Red sd.</i>	<i>220</i>	<i>228</i>
<i>Blue clay</i>	<i>228</i>	<i>270</i>
<i>Coarse Blue sd.</i>	<i>270</i>	<i>292</i>

CODED


DRILLERS REMARKS:

NOV 8 1973

(X)

If well telescopes please sketch and show depths.

GROUND LEVEL

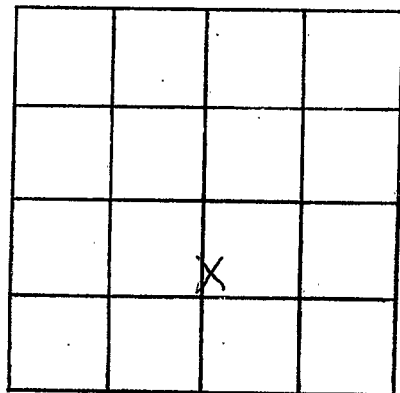

SECTION 28

Please indicate well location X.

ADDITIONAL INFORMATION

If more than one screen, show locations of each on sketch.