

Pearl River
 G 36
 11-28-73

MISSISSIPPI
 BOARD OF WATER COMMISSIONERS
 416 North State Street
 Jackson, Mississippi 39201

CODED

WATER WELL DRILLERS LOG

11-28-73 19 Stafford Waterwell Dr. Pearl River
 date well completed firm name county well located

LANDOWNER: Earl Masoner
Rt-1 Box 53 B
Poplarville Miss
 (mailing address)

description of formations encountered	from	to
<u>Top Soil</u>	<u>0</u>	<u>16</u>
<u>Chalk</u>	<u>16</u>	<u>60</u>
<u>Sand & Gravel</u>	<u>60</u>	<u>80</u>
<u>Chalk</u>	<u>80</u>	<u>140</u>
<u>Sand & Gravel</u>	<u>140</u>	<u>165</u>

WELL LOCATION:
 sec. 7 T. 2 N. R. 15 E
5 miles North of Poplarville
 (distance) (direction) (nearest town)

WELL PURPOSE:
 (home, irrigation, municipal, industrial)

WELL COMPLETION DATA:

(1) diameter (inches) 4

(2) total depth (feet) 165

(3) static water level (feet) 8 below top of ground.

(4) casing 4 155
 (material) (depth)

4 If telescope see back.
 (size)

(5) screen 10 155
 (length) (depth to top)

4 Plastic
 (size) (material)

(6) pump 1/2 HP 10
 (HP) (yield gpm)

elec
 (type power)

(7) electric log yes
 (yes or no)

(organization running log)

(8) how well bottom plugged B&V


DRILLERS REMARKS:
Cleve Duncan

CODED

DEC 7 1973

If well telescopes please sketch and show depths.

GROUND LEVEL

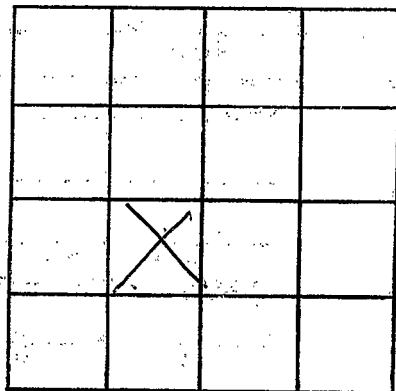

SECTION 7

Please indicate well location X.

ADDITIONAL INFORMATION

If more than one screen, show locations of each on sketch.