

Pearl River
 G 37
 5-12-75

MISSISSIPPI
 BOARD OF WATER COMMISSIONERS
 416 North State Street
 Jackson, Mississippi 39201

CODED

WATER WELL DRILLERS LOG

5-12 19 25 Bud Pentecost Pearl River
 date well completed firm name county well located

LANDOWNER:
 Vigil Barge
 Rt. 2, Poplarville,
 (mailing address)

description of formations encountered	from	to
Red Shale	0	12
Red Shale	12	27
Grey Shale	27	60
White Sand	60	112

WELL LOCATION:
 sec. 26 T 2 N R 13 E 13 S
 3 miles (distance) of Poplarville (direction) (nearest town)

WELL PURPOSE: Home
 (home, irrigation, municipal, industrial)


- WELL COMPLETION DATA:
- diameter (inches) 4 in
 - total depth (feet) 112
 - static water level (feet) 23 below top of ground
 - casing PVC 102 (material) (depth)
 (size) if telescope see back.
 - screen 4x10, 102 (length) (depth to top)
 1/2 PVC (size) (material)
 - pump 1/2 (HP) 600 (yield gpm)
 electric (type power)
 - electric log NO (yes or no)
 (organization running log)
 - how well bottom plugged Sand Shale

RECEIVED
 JUN 23 1975

DRILLERS REMARKS:

If well telescopes please sketch and show depths.

GROUND LEVEL

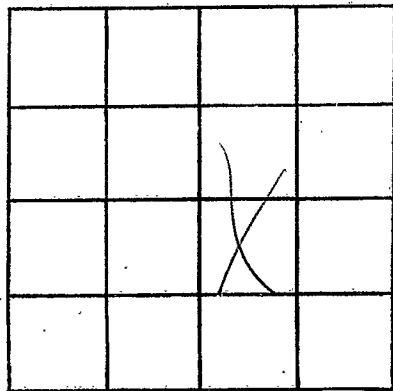

SECTION _____

Please indicate well location X.

ADDITIONAL INFORMATION

If more than one screen,
show locations of each on sketch.