

Pearl River  
 G 38  
 8-19-75

MISSISSIPPI  
 BOARD OF WATER COMMISSIONERS  
 416 North State Street  
 Jackson, Mississippi 39201

CODED

WATER WELL DRILLERS LOG

8-19 1975  
 date well completed

Danell Anderson  
 firm name

Pearl River  
 county well located

LANDOWNER:	description of formations encountered	from	to
Helton Murray (mailing address)			
WELL LOCATION:	White Clay	4	42
sec. 21 T 8 N R 15 E S W	Blue Clay	42	79
2 miles NE of Poplarville	Hard Sand	79	95
(distance) (direction) (nearest town)	Coarse Sand	95	109
WELL PURPOSE: HOME			
(home, irrigation, municipal, industrial)			
WELL COMPLETION DATA:			
(1) diameter (inches) 2"			
(2) total depth (feet) 109'			
(3) static water level (feet) 32' below top of ground.			
(4) casing Plastic, 100' (material) (depth)			
(size) if telescope see back.			
(5) screen 5' 100' (length) (depth to top)			
2" Plastic (size) (material)			
(6) pump 1 10 (HP) (yield gpm)			
Elect (type power)			
(7) electric log no (yes or no)			
(organization running log)			
(8) how well bottom plugged Plugged			
DRILLERS REMARKS:			


CODED

RECEIVED  
 SEP - 4 1975

MISS. BD. OF WATER COMMISSIONERS

If well telescopes please sketch and show depths.

GROUND LEVEL

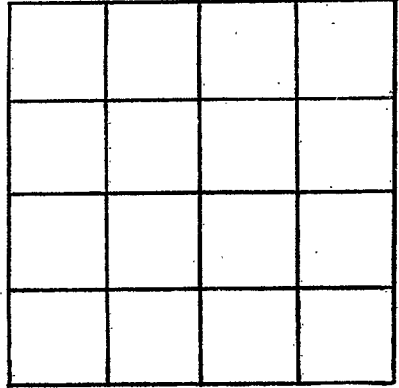

SECTION \_\_\_\_\_

Please indicate well location X.

ADDITIONAL INFORMATION

If more than one screen, show locations of each on sketch.