

MISSISSIPPI
BOARD OF WATER COMMISSIONERS
416 North State Street
Jackson, Mississippi 39201

CODED

WATER WELL DRILLERS LOG

PEARL RIVER
G 39

1/11/81
1/11
date well completed

1981 Bird Benton
Water Well Service
firm name

Pearl River
county well located

LANDOWNER: Walter Slott
R T. 3 Bob Poplar
Miss
(mailing address)

description of formations encountered	from to	
Red Shale	0	120
Blue Shale	120	175
Blue Sand	175	230
Blue Shale	230	345
Gravel	345	370
White Shale	370	820
Gray Sand	820	925

WELL LOCATION:
sec. 22 T. 3 N. R. 16 E.
2 (S) 15 (W)
1/4 miles East of Poplar
(distance) (direction) (nearest town)

WELL PURPOSE: house
(home, irrigation, municipal, industrial)



- WELL COMPLETION DATA:
- diameter (inches) 4x2
 - total depth (feet) 925
 - static water level (feet) 150 below top of ground.
 - casing PVC (material), 925 (depth)
4x2 if telescope see back. (size)
 - screen 2x15 (length), 910 (depth to top)
12 (size), PVC (material)
 - pump 1 1/2 (HP), 13 1/2 (yield gpm)
Elect (type power)
 - electric log no (yes or no)
 - (organization running log)
 - how well bottom plugged

DRILLERS REMARKS: Sharp

DEPT. OF NATURAL RESOURCES
BUREAU OF LAND & WATER RESOURCES
RECEIVED
FEB 13 1981

If well telescopes please sketch and show depths.

GROUND LEVEL

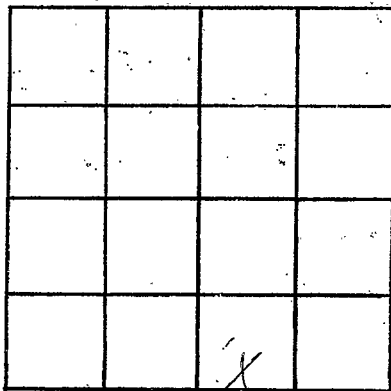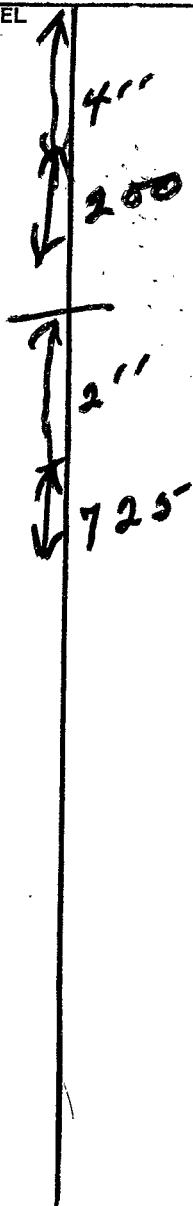

SECTION _____

Please indicate well location X.

ADDITIONAL INFORMATION

Lined area for additional information.

If more than one screen, show locations of each on sketch.