

Pearl River
G 40
8/5/81

MISSISSIPPI
BOARD OF WATER COMMISSIONER
416 North State Street
Jackson, Mississippi 39201

CODED

WATER WELL DRILLERS LOG
BRADEN PUMP AND WELL SERVICE, INC.
ROUTE 1, BOX 489
SAUCIER, MS ^{firm name} 39574

Pearl
River

8-5-81
date well completed

county well located

LANDOWNER:
WAYNE WARD
Rt. 2, Box 314CC
Poplarville, MS 39470
(mailing address)

description of formations encountered	from	to
CLAY	0	40
SAND	40	60
CLAY	60	120
SAND	120	170
CLAY	170	275
SAND	275	280
CLAY	280	395
SAND	395	400
CLAY	400	415
SAND	415	460


WELL LOCATION:
sec 29 T 2 N R 15 E
1 miles E of Poplarville
(distance) (direction) (nearest town)

WELL PURPOSE: home
(home, irrigation, municipal, industrial)

- WELL COMPLETION DATA:
- (1) diameter (inches) 4"
 - (2) total depth (feet) 460'
 - (3) static water level (feet) 140' below top of ground.
 - (4) casing PVC 460'
(material) (depth)
4" if telescope see back.
(size)
 - (5) screen 10' 445'
(length) (depth to top)
2" PVC underbar
(size) (material)
 - (6) pump 1 1/2 22
(HP) (yield gpm)
230
(type power)
 - (7) electric log NO
(yes or no)
- (organization running log)

(8) how well bottom plugged
2 1/2" SAND SHARK

DRILLERS REMARKS:
SI tail pipe

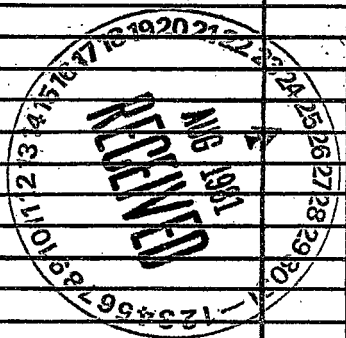

DEPT. OF NATURAL RESOURCES
BUREAU OF LAND & WATER RESOURCES
AUG 25 1981

RECEIVED

If well telescopes please sketch and show depths.

GROUND LEVEL

X			

SECTION 29

Please indicate well location X.

ADDITIONAL INFORMATION

If more than one screen, show locations of each on sketch.