

MISSISSIPPI DEPARTMENT OF NATURAL RESOURCES

Bureau of Land and Water Resources

Southport Mall

P.O. Box 10631

Jackson, Mississippi 39209

WATER WELL DRILLERS LOG

Pearl R.  
542  
11/4/82

COPIED

COL

Nov. 4 1982 Brooks Pump & Well Co. Pearl River  
date well completed firm name county well located

LANDOWNER: W.W. Watson  
Rt. 5, Box 148  
Poplarville, Miss.  
(mailing address)

description of formations encountered	from	to
Clay White	0	200
Sand Brown	200	260
Clay Blue	260	440
Sand Brown	440	540
Clay	540	560
Brown Sand	560	615
Blue Clay	615	780
Sand Break	780	800
Blue & Brown Clay	800	1050
Sand	1050	1115
Blue Clay	1115	1400
Grey Sand	1400	1540
Clay	1540	+

WELL LOCATION:  
sec. 7 T. 2 S. R. 15 E.  
2 miles N of Poplarville  
(distance) (direction) (nearest town)

WELL PURPOSE: Home  
(home, irrigation, municipal, industrial)

- WELL COMPLETION DATA:
- (1) diameter (inches) 6" x 4"
  - (2) total depth (feet) 1545
  - (3) static water level (feet) 195 below above top of ground.
  - (4) casing Steel 1194  
(material) (depth)  
6" x 4" if telescope see back.  
(size)
  - (5) screen 30 1494  
(length) (depth to top)  
4" S.S. Underbar  
(size) (material)
  - (6) pump 10 100  
(HP) (yield gpm)  
220V 1P  
(type power)
  - (7) electric log Yes  
(yes or no)  
Miss. Geological Survey  
(organization running log)
  - (8) how well bottom plugged 4" Back Wash Check

COPIED

DEPT. OF NATURAL RESOURCES  
BUREAU OF LAND & WATER RESOURCES

NOV 15 1982

RECEIVED

DRILLERS REMARKS:

If well telescopes please sketch and show depths.

GROUND LEVEL

6"  
Steel

396W

6" X 4"  
Swedge Nipple

4" Steel


1494 →

1524 →

1545 →

36 FT - 4"  
S, S, Screen

4" Back  
Wash Check

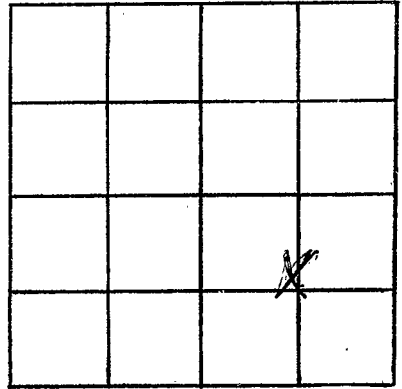

SECTION 7

Please indicate well location X.

ADDITIONAL INFORMATION

If more than one screen,  
show locations of each on sketch.