

MISSISSIPPI DEPARTMENT OF NATURAL RESOURCES

Bureau of Land and Water Resources

Southport Mall

P.O. Box 10631

Jackson, Mississippi 39209

WATER WELL DRILLERS LOG

CODED

G 43
Pearl River
9-3-83

9/3 1983 Bradley Pump & Well Serv. Pearl River
 date well completed (Well #1) firm name county well located

LANDOWNER: Bill Watson

description of formations encountered	from	to
red clay	0	10
sand + gravel	10	22
white clay	22	180
blue clay	180	198
sand, gravel + black	198	242

Poplarville, Ms.
 (mailing address)

WELL LOCATION:
 sec. 7 T 2 S R 15 E
2 miles N of Poplarville
 (distance) (direction) (nearest town)

WELL PURPOSE: None
 (home, irrigation, municipal, industrial)

WELL COMPLETION DATA:

- (1) diameter (inches) 4"
- (2) total depth (feet) 242
- (3) static water level (feet) 120 below top of ground.
- (4) casing PVC, 202 (material) (depth)
4" if telescope see back. (size)
- (5) screen 40', 202 (length) (depth to top)
4", PVC (size) (material)
- (6) pump 5HP, 75 (HP) (yield gpm)
230V (type power)
- (7) electric log NO (yes or no)
 (organization running log)
- (8) how well bottom plugged 2" PVC sand/shark

DRILLERS REMARKS:


DEPT. OF NATURAL RESOURCES
 BUREAU OF LAND & WATER RESOURCES

OCT 17 1983

RECEIVED

If well telescopes please sketch and show depths.

GROUND LEVEL

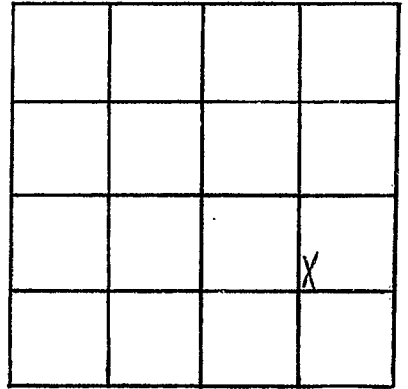

SECTION 7

Please indicate well location X.

ADDITIONAL INFORMATION

If more than one screen,
show locations of each on sketch.