

MISSISSIPPI DEPARTMENT OF NATURAL RESOURCES

Bureau of Land and Water Resources

Southport Mall

P.O. Box 10631

Jackson, Mississippi 39209

CODED

WATER WELL DRILLERS LOG

G 44  
 Pearl River  
 9-3-83

19 Braden Pump & Well Service Pearl River  
 date well completed (well #2) firm name county well located

LANDOWNER: Bill Watson  
Poplarville, Ms.  
 (mailing address)

description of formations encountered	from	to
<u>red clay</u>	<u>0</u>	<u>8</u>
<u>gravel</u>	<u>8</u>	<u>16</u>
<u>white clay</u>	<u>16</u>	<u>189</u>
<u>blue clay</u>	<u>189</u>	<u>209</u>
<u>dark brown with black specks</u>	<u>209</u>	<u>280</u>

WELL LOCATION:  
 sec. 7 T. 2 N. R. 15 W.  
2 miles N of Poplarville  
 (distance) (direction) (nearest town)

WELL PURPOSE: home  
 (home, irrigation, municipal, industrial)

WELL COMPLETION DATA:  
 (1) diameter (inches) 4"  
 (2) total depth (feet) 280  
 (3) static water level (feet) 120 <sup>below</sup> above top of ground.  
 (4) casing PVC, 230'  
 (material) (depth)  
4" if telescope see back.  
 (size)  
 (5) screen 50', 230'  
 (length) (depth to top)  
4", PVC  
 (size) (material)  
 (6) pump 5HP, 75  
 (HP) (yield gpm)  
230  
 (type power)  
 (7) electric log NO  
 (yes or no)  
 (organization running log)

(8) how well bottom plugged 2" PVC sandshark

DRILLERS REMARKS:

CODED


DEPT. OF NATURAL RESOURCES  
 BUREAU OF LAND & WATER RESOURCES

OCT 17 1983

RECEIVED

If well telescopes please sketch and show depths.

GROUND LEVEL

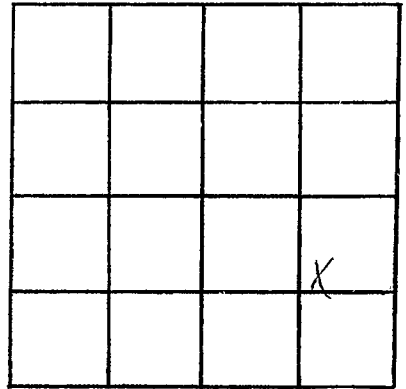

SECTION 7

Please indicate well location X.

ADDITIONAL INFORMATION

If more than one screen,  
show locations of each on sketch.