

MISSISSIPPI DEPARTMENT OF NATURAL RESOURCES

Bureau of Land and Water Resources

Southport Mall

P.O. Box 10631

Jackson, Mississippi 39209

CODED

WATER WELL DRILLERS LOG

G45
PEARL RIVER
11-19-84

11/19/84 date well completed
184 Braden Pump & Well Pearl River firm name
county well located

LANDOWNER: Bill Watson Investment
Highway #11 N.
Poplarville, Miss 39470
(mailing address)

description of formations encountered	from	to
clay	0	100
clay + sand	100	130
clay	130	200
clay + sand	200	220
sand	220	270
clay	270	280

WELL LOCATION:
sec. 7 T2 R. 15 S. W.
2 miles N of Poplarville
(distance) (direction) (nearest town)

WELL PURPOSE: farm
(home, irrigation, municipal, industrial)

WELL COMPLETION DATA:

(1) diameter (inches) 4"
(2) total depth (feet) 280 ft
(3) static water level (feet) 130 below top of ground.
(4) casing PVC, 240' (material) (depth)
4' (size) if telescope see back.
(5) screen 30' 240' (length) (depth to top)
4" PVC underbar (size) (material)
(6) pump 5 60 (HP) (yield gpm)
230 V (type power)
(7) electric log No (yes or no)
(organization running log)
(8) how well bottom plugged PVC sand shark

DRILLERS REMARKS: 10 ft. tailpipe


DEPT. OF NATURAL RESOURCES
BUREAU OF LAND & WATER RESOURCES

DEC - 4 1984

RECEIVED

If well telescopes please sketch and show depths.

GROUND LEVEL

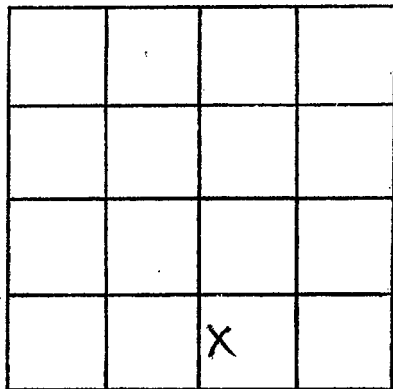

SECTION 7

Please indicate well location X.

ADDITIONAL INFORMATION

If more than one screen,
show locations of each on sketch.