

MISSISSIPPI DEPARTMENT OF NATURAL RESOURCES

Bureau of Land and Water Resources

Southport Mall

P.O. Box 10631

Jackson, Mississippi 39209

WATER WELL DRILLERS LOG

CODED

Leaf River
G-46
10-31-85

10/31 1985 date well completed
 Penton & Son firm name
 Pearl River county well located

LANDOWNER: Owen Monette
RT-2 Box 68 M Poplarville
Miss
 (mailing address)

description of formations encountered	from	to
<u>Red shale</u>	<u>0</u>	<u>40</u>
<u>white shale</u>	<u>40</u>	<u>185</u>
<u>white sand</u>	<u>185</u>	<u>204</u>

WELL LOCATION:
 sec. 29 T. 2 N. R. 15 E.
1 1/2 miles East of Poplarville
 (distance) (direction) (nearest town)

WELL PURPOSE: home
 (home, irrigation, municipal, industrial)

- WELL COMPLETION DATA:
- (1) diameter (inches) 4"
 - (2) total depth (feet) 204
 - (3) static water level (feet) 100 below above top of ground.
 - (4) casing Pvc, 294,
 (material) (depth)
20 if telescope see back.
 (size)
 - (5) screen 10, 194
 (length) (depth to top)
12, Pvc
 (size) (material)
 - (6) pump 1, 950
 (HP) (yield gpm)
Elect
 (type power)
 - (7) electric log no
 (yes or no)
 (organization running log)
 - (8) how well bottom plugged plugged


RECEIVED
 NOV 20 1985

Department of Natural Resources
 Bureau of Land & Water Resources

DRILLERS REMARKS:

If well telescopes please
sketch and show depths.

GROUND LEVEL

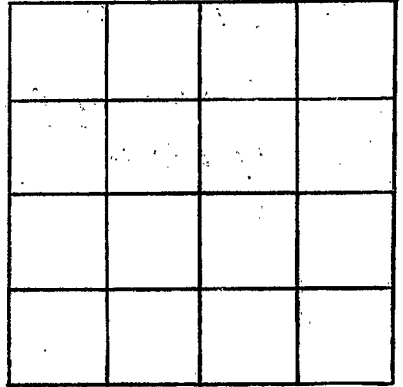

SECTION _____

Please indicate well location X.

ADDITIONAL INFORMATION

If more than one screen,
show locations of each on sketch.