

Pearl River
247

MISSISSIPPI DEPARTMENT OF NATURAL RESOURCES
Bureau of Land and Water Resources
Southport Mall
P.O. Box 10631
Jackson, Mississippi 39209
WATER WELL DRILLERS LOG

CODED

MAY 26, 1987 date well completed GRINER DRILLING SER. firm name PEARL RIVER county well located

LANDOWNER: CITY OF
POPLARVILLE - TODD
ST. WELL
(mailing address)

description of formations encountered	from	to
<u>TOP SOIL</u>	<u>0</u>	<u>3</u>
<u>SAND Red + silt</u>	<u>3</u>	<u>38</u>
<u>CLAY</u>	<u>38</u>	<u>132</u>
<u>SAND + CLAY STREAMS</u>	<u>132</u>	<u>190</u>
<u>CLAY</u>	<u>190</u>	<u>430</u>
<u>SAND + CLAY STREAMS</u>	<u>430</u>	<u>474</u>
<u>SAND</u>	<u>474</u>	<u>568</u>
<u>CLAY</u>	<u>568</u>	<u>650</u>


WELL LOCATION: NW 1/4 SW 1/4
sec. 2 T. 2 N. R. 15 E.
(S) (W)
_____ miles _____ of _____
(distance) (direction) (nearest town)

WELL PURPOSE:
(home, irrigation, municipal, industrial)

WELL COMPLETION DATA:

- (1) diameter (inches) 12 3/4
- (2) total depth (feet) 568
- (3) static water level (feet) 156.62 below top of ground.
- (4) casing Steel, 508
(material) (depth)
12 3/4 if telescope see back.
(size)
- (5) screen 50', 518'
(length) (depth to top)
8", 304 S.S. (.016)
(size) (material)
- (6) pump 40, 503
(HP) (yield gpm)
Elect
(type power)
- (7) electric log Yes
(yes or no)
MOS
(organization running log)
- (8) how well bottom plugged BACK
VALVE + string + cement

CODED

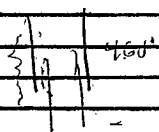

RECEIVED


MAY 28 1987

Department of Natural Resources
Bureau of Land & Water Resources

DRILLERS REMARKS:

If well telescopes please
sketch and show depths.

GROUND LEVEL

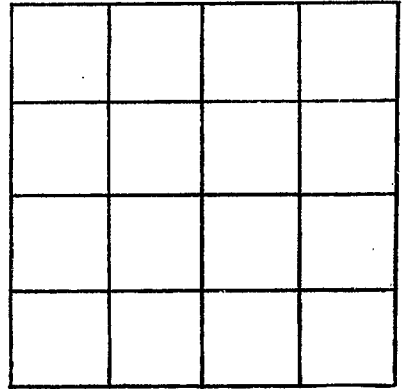

SECTION _____

Please indicate well location X.

ADDITIONAL INFORMATION

If more than one screen,
show locations of each on sketch.