




If well telescopes, please sketch and show depths.

GROUND LEVEL

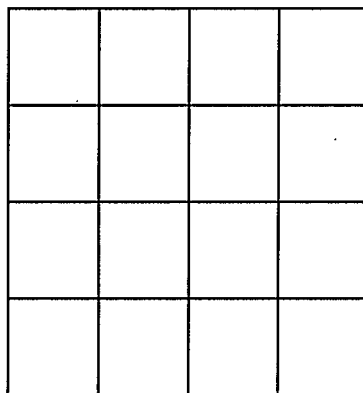

SECTION \_\_\_\_\_

Please indicate well location X .

ADDITIONAL INFORMATION

If more than one screen, show location of each on sketch.