

MAR-9-2002 08:14A FROM:

TD:16013600535

P:2

State Well Report

Part 1

Mississippi Department of Environmental Quality
 Office of Land and Water Resources
 P.O. Box 10631
 Jackson, MS 39289-0631
 (601)961-5210
 (601)354-6938 (fax)

For Office Use Only:

Aquifer: _____
 Well #: G-68
 L. S. Elevation: _____
 B-log #: _____

County: Pearl River
 Permit #: _____
 Driller: Travis Boone
 Date drilling completed: 12-6-05

State Law requires that this report be prepared by the driller in detail and filed with the Department within 30 days of completion of drilling of the well.

Well Owner Information	Well Location
Owner Name: <u>Lloyd Reid</u>	Latitude: _____ " Longitude: _____ "
Mailing Address: <u>3 Colton Ln</u> <u>Poplarville, MS</u>	Method of Lat/Long (circle one): <input type="checkbox"/> Conventional Survey, <input type="checkbox"/> USGS quad, <input type="checkbox"/> Hand-held GPS, <input type="checkbox"/> Survey-grade GPS
<u>39470</u>	<u>1/4</u> <u>1/4</u> Sec <u>34</u> Twn <u>2S</u> Rng <u>15W</u>
City State Zip Code	Distance Direction Nearest Town
Telephone No. () _____	<u>3</u> Miles <u>E</u> of <u>Poplarville</u>

Well Data

Purpose of Well (circle one) Home Industrial Public Supply Irrigation Fish Culture Other: _____

Date well drilling started: 12-6-05 Date well drilling completed: 12-6-05

If flowing, method of flow regulation: Valve _____ Other (describe) _____

Static Water Level: 110 feet above or below (circle one) land surface Date measured: 12-6-05

Method of Measurement (circle one) steel tape electric tape air line other: string LN

Hole depth: _____ Well depth: 200 Well grouted to a depth of 10 feet

Type of grout (circle one): Cement Bentonite Mix

Casing length: 180 feet Casing diameter: 4 inches Type of casing: sch 40

Screen length: 20 feet Screen diameter: 4 inches Type of screen: sch 40

Screen slot size: 8 inches Setting depth: From 180 feet to 200 feet

Type of completion (circle all applicable): Gravel packed Underreamed Telescoped Open hole Natural Development
 Other (describe): _____

Top of lap pipe or reduction in casing: _____ feet. If telescoped or more than one screen, describe on back of page

Logs run (circle all applicable): No log run Electric Gamma Ray Density Sonic Neutron Other: _____

Name of organization running log(s): _____

I certify that the well was drilled, constructed, and completed in accordance with all applicable requirements of the Mississippi Department of Environmental Quality and/or the Mississippi Department of Health regulations and state laws.

Travis Boone 0-514
 Print Name of Water Well Contractor and License No. Travis Boone
Signature of Water Well Contractor

RECEIVED
 JAN 05 2006
 BY: OLWR

MAR-9-2002 08:14A FROM:


TO: 16013600535

P: 4

G-63

If well telescopes please sketch below and show depths.

Ground Level

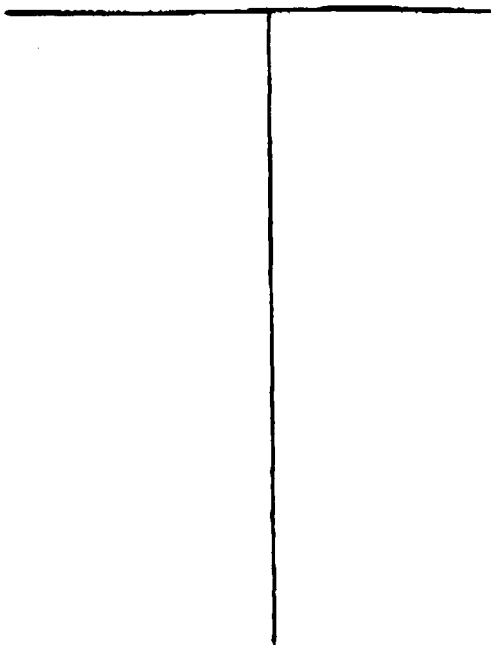

Description of Formations Encountered

From To

Description of Formations Encountered	From	To
Clay	0	10
Clay sand	10	12
Clay	12	160
sand	160	200

If more than one screen, show location of each on sketch

Sketch the property layout and include the following: 1) the well location; 2) any permanent structures on the property that may aid in locating the well; 3) any roads, power lines, or other items that may aid in locating the property and the well; 4) indicate direction.

Landowner Name: Lloyd Reid


Signature of Water Well Contractor

RECEIVED
JAN 05 2006
BY: OLWR

MAR-9-2002 08:14A FROM:

TO:16013600535

P:3

STATE WELL REPORT

Part 2

Pump Installer's Completion Report
Mississippi Department of Environmental Quality
Office of Land and Water Resources
P.O. Box 10831
Jackson, MS 39289-0631
(601)961-5210
(601)354-6938 (fax)

County: Pearl River
 Permit #: _____
 Driller: TRAVIS BOONE
 Date completed: 12-6-05

For Office Use Only:
 Aquifer: _____
 Well #: 6-1-9
 Elevation: _____

This report should be prepared by the pump installer in detail and filed with the Department within 30 days of the installation of pump.

Well Owner Information	Well Location
Owner Name: <u>Lloyd Reid</u>	Latitude: _____ Longitude: _____
Mailing Address: <u>3 COLTON LANE</u> <u>Poplarville, MS</u>	Method of Lat/Long (circle one): <u>Conventional Survey</u>
City: _____ State: <u>39470</u> Zip Code: _____	USGS quad, Hand-held GPS, Survey-grade GPS
Telephone No. () _____	<u>14</u> Sec <u>34</u> Twp <u>2S</u> Rng <u>15W</u>
	Distance _____ Direction _____ Nearest Town _____
	<u>3</u> Miles <u>E</u> of <u>Poplarville</u>

Pump Type Circle one	Power Type Circle one
Air Lift <input type="checkbox"/> Jet <input type="checkbox"/> <u>Submersible</u>	Diesel Engine <input type="checkbox"/> Gasoline Engine <input type="checkbox"/> Natural Gas <input type="checkbox"/>
Bucket <input type="checkbox"/> Piston <input type="checkbox"/> Turbine <input type="checkbox"/>	<u>Electric Motor</u> <input type="checkbox"/> Hand <input type="checkbox"/> Tractor PTO <input type="checkbox"/>
Centrifugal <input type="checkbox"/> Rotary <input type="checkbox"/> Flowing Well <input type="checkbox"/>	Windmill <input type="checkbox"/> Other (specify): _____
Other (specify): _____	Horse Power Rating of Motor: _____
Date Pump Installed: <u>12-6-05</u>	Setting Depth: <u>150</u> feet
Rated Pump Capacity: <u>12</u> Gallons Per Minute	Number of Stages: _____

Pump Test Data	Method of Measuring Water Level Circle one
Date Well Tested: <u>12-6-05</u>	Air Line <input type="checkbox"/> Electric Measuring Line <input type="checkbox"/> Steel Tape <input type="checkbox"/>
Static Water Level (A): <u>110</u> Feet Below Land Surface	Other (specify): <u>STRING LINE</u>
Pumping Water Level (B): _____ Feet Below Land Surface	For flowing well, measured shut in head: _____ feet
Drawdown [(B) - (A)]: _____ Feet Below Land Surface	Well yielded _____ GPM with a drawdown of _____ feet after _____ hours of pumping
Test Pumping Rate: <u>110 OF</u> Gallons Per Minute	
Duration of Pump Test (minimum 4 hours): _____ hours	

I HEREBY CERTIFY that the above statements are true to the best of my knowledge.

TRAVIS BOONE 0-514 _____
 Print Name of Pump Installer and License No. (if applicable) Signature of Pump Installer

RECEIVED
JAN 05 2006
BY: OLWR