

Pearl River
G 2002
1-68

MISSISSIPPI
 BOARD OF WATER COMMISSIONERS
 416 North State Street
 Jackson, Mississippi 39201

WATER WELL DRILLERS LOG

JAN. 20 1968 LR NEIL HUMPKIN WELL Pearl River
 date well completed firm name county well located
DRILLING SERVICE

LANDOWNER: ST. REGIS PAPER CO.

description of formations encountered	from	to
<u>white chalk clay</u>	<u>0</u>	<u>100</u>
<u>blue clay</u>	<u>100</u>	<u>150</u>
<u>good sand</u>	<u>150</u>	<u>174</u>

RICAYUNE, MISS.
 (mailing address)


WELL LOCATION:
 sec. 29 T. 2 N. R. 15 E.
 S W
2 miles EAST of Paplarville
 (distance) (direction) (nearest town)

WELL PURPOSE: OFFICE BLDG.
 (home, irrigation, municipal, industrial)

WELL COMPLETION DATA:


- diameter (inches) 2"
- total depth (feet) 174
- static water level (feet) 90' below top of ground.
- casing plastic, 164'
 (material) (depth)
2" if telescope see back.
 (size)
- screen 5'
 (length) (depth to top)
2", plastic
 (size) (material)
- pump 1 Statate 390 per/hr.
 (HP) (yield gpm)
electric
 (type power)
- electric log no.
 (yes or no)
 (organization running log)
- how well bottom plugged Johnson BP Valve

DRILLERS REMARKS:

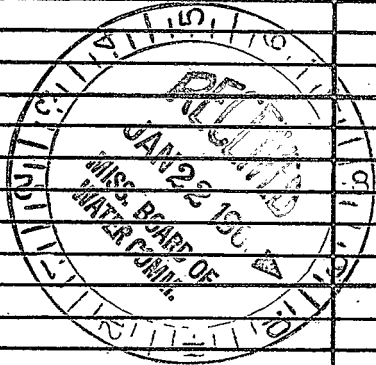

If well telescopes please sketch and show depths.

GROUND LEVEL

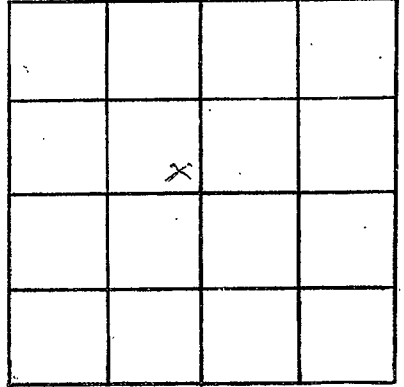

SECTION 29

Please indicate well location X.

ADDITIONAL INFORMATION

Highway 26

If more than one screen,
show locations of each on sketch.