

Pearl River
G 2003
6-30-76

MISSISSIPPI
 BOARD OF WATER COMMISSIONERS
 416 North State Street
 Jackson, Mississippi 39201

WATER WELL DRILLERS LOG

6-30 1976 Hollinger Plumbing Pearl River
 date well completed firm name county well located

LANDOWNER: Pete Plaisance
Rt 2 Box 313
Poplarville, Miss 39470
 (mailing address)

description of formations encountered	from	to
	<u>CLAY</u>	<u>0</u>
<u>GRAVEL</u>	<u>30</u>	<u>40</u>
<u>SAND & chalk</u>	<u>40</u>	<u>50</u>
<u>SAND</u>	<u>50</u>	<u>100</u>

WELL LOCATION:
 sec. 22 T. 2 N. R. 15 E
4 miles east of Poplarville
 (distance) (direction) (nearest town)

WELL PURPOSE: Industrial
 (home, irrigation, municipal, industrial)


- WELL COMPLETION DATA:
- (1) diameter (inches) 4"
 - (2) total depth (feet) 100
 - (3) static water level (feet) 40 below top of ground. above
 - (4) casing pvc (material) (depth)
No (size) if telescope see back.
 - (5) screen 5 95 (length) (depth to top)
4" (size) pvc (material)
 - (6) pump 3/4 12 (HP) (yield gpm)
elect. (type power)
 - (7) electric log No (yes or no)
N (organization running log)
 - (8) how well bottom plugged sand stark

DRILLERS REMARKS: good well

MISSISSIPPI BOARD OF WATER COMMISSIONERS
 JUL 2 1976
 MISS. Bd. of Water Comm.

If well telescopes please sketch and show depths.

GROUND LEVEL

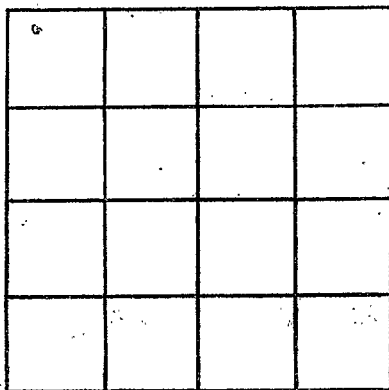

SECTION 22

Please indicate well location X.

ADDITIONAL INFORMATION

If more than one screen, show locations of each on sketch.