

Pearl River
 15 2005
 9/24/77

MISSISSIPPI
 BOARD OF WATER COMMISSIONERS
 416 North State Street
 Jackson, Mississippi 39201

WATER WELL DRILLERS LOG

9/24 1977 Hollinger Well Serv. Pearl River
 date well completed firm name county well located

LANDOWNER:	description of formations encountered	from	to
Gladys Ragland Rt 3 Box 277 Poplarville, Ms. (mailing address)			

WELL LOCATION:
 sec. 25 T 2 N R 15 E
 6 miles W of Poplarville
 (distance) (direction) (nearest town)

WELL PURPOSE: Home
 (home, irrigation, municipal, industrial)

WELL COMPLETION DATA:

(1) diameter (inches) 2"
 (2) total depth (feet) 80
 (3) static water level (feet) 40 (below top of ground)
 (4) casing pvc, 75"
 (material) (depth)
 (size) if telescope see back.
 (5) screen 5', pvc 75"
 (length) (depth to top)
 2" pvc
 (size) (material)
 (6) pump 1/2 HP, 6
 (type power) (yield gpm)
 elect
 (type power)
 (7) electric log (yes or no)
 (organization running log)

(8) how well bottom plugged sand
 shale


DRILLERS REMARKS: Very good

RECEIVED

NOV 30 1977

If well telescopes please sketch and show depths.

GROUND LEVEL

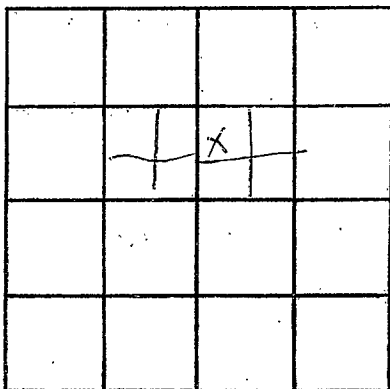

SECTION 25

Please indicate well location X.

ADDITIONAL INFORMATION

If more than one screen, show locations of each on sketch.