

Pearl River  
 G 2000  
 2/15/78

MISSISSIPPI  
 BOARD OF WATER COMMISSIONERS  
 416 North State Street  
 Jackson, Mississippi 39201

WATER WELL DRILLERS LOG

2-15-1978 Parnell Anderson Pearl River  
 date well completed firm name county well located


| LANDOWNER:  | description of formations encountered | from       | to         |
|---|---------------------------------------|------------|------------|
| <u>W. C. Ballard</u>  | <u>Top Soil</u>                       | <u>0</u>   | <u>2</u>   |
| (mailing address)   | <u>Blue Clay</u>                      | <u>2</u>   | <u>100</u> |
| WELL LOCATION:  | <u>7 in Sand</u>                      | <u>100</u> | <u>148</u> |
| sec <u>27</u> T <u>2</u> R <u>15</u>                          | <u>Course Sand</u>                    | <u>148</u> | <u>170</u> |
| <u>3</u> miles <u>E</u> of <u>Poplarville</u>                 |                                       |            |            |
| (distance) (direction) (nearest town)                         |                                       |            |            |
| WELL PURPOSE: <u>HOME</u>                                     |                                       |            |            |
| (home, irrigation, municipal, industrial)                     |                                       |            |            |
| WELL COMPLETION DATA:   |                                       |            |            |
| (1) diameter (inches) <u>2"</u>                               |                                       |            |            |
| (2) total depth (feet) <u>170'</u>                            |                                       |            |            |
| (3) static water level (feet) <u>70'</u> below top of ground. |                                       |            |            |
| (4) casing <u>Plastic, 165'</u>                               |                                       |            |            |
| (material) (depth)  |                                       |            |            |
| (size) if telescope see back.                                 |                                       |            |            |
| (5) screen <u>5'</u> , <u>165'</u>                            |                                       |            |            |
| (length) (depth to top)                                       |                                       |            |            |
| <u>2"</u> , <u>Plastic</u>                                    |                                       |            |            |
| (size) (material)   |                                       |            |            |
| (6) pump <u>1</u> , <u>8</u>                                  |                                       |            |            |
| (HP) (yield gpm)  |                                       |            |            |
| <u>Elect</u>  |                                       |            |            |
| (type power)  |                                       |            |            |
| (7) electric log <u>no</u>                                    |                                       |            |            |
| (yes or no)   |                                       |            |            |
| (organization running log)                                    |                                       |            |            |
| (8) how well bottom plugged <u>Capped</u>                     |                                       |            |            |
| DRILLERS REMARKS:   |                                       |            |            |

RECEIVED  
 MAR - 7 1978

MISS. BD. OF WATER COMM

If well telescopes please sketch and show depths.

GROUND LEVEL

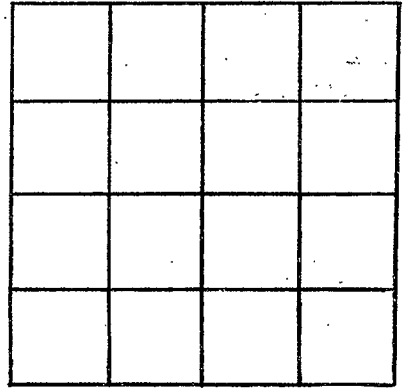

SECTION \_\_\_\_\_

Please indicate well location X.

ADDITIONAL INFORMATION

If more than one screen,  
show locations of each on sketch.