

PEARL RIVER

G 2009

9-30-78

MISSISSIPPI BOARD OF WATER COMMISSIONERS 416 North State Street Jackson, Mississippi 39201

WATER WELL DRILLERS LOG

9-30-1978

78 Carmel Anderson Pearl River

date well completed

firm name

county well located

LANDOWNER:

Gerald Matthews

(mailing address)

WELL LOCATION:

sec. 85 T 2 N R 15 E S W of Poplarville (distance) 5 miles (direction) E (nearest town)

WELL PURPOSE: HOME (home, irrigation, municipal, industrial)

WELL COMPLETION DATA:

- (1) diameter (inches) 2"
(2) total depth (feet) 138
(3) static water level (feet) 82 below top of ground.
(4) casing Plastic 133 (material) (depth)
(5) screen 5" 133 (length) (depth to top) 2" Plastic (size) (material)
(6) pump 1 1/2 (HP) 9 (yield gpm) Elect (type power)
(7) electric log no (yes or no)

(organization running log)

(8) how well bottom plugged capped


DRILLERS REMARKS:

description of formations encountered

from

to

Table with 3 columns: description of formations encountered, from, to. Rows include Top Soil (0-2), Sandy clay (2-28), Course Sand (28-42), Clay (42-75), Fine Sand (75-82), Clay (82-126), Course Sand (126-138).

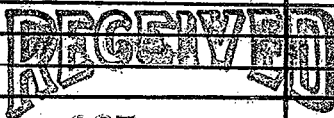

OCT 12 1978

If well telescopes please sketch and show depths.

GROUND LEVEL

SECTION _____

Please indicate well location X.

ADDITIONAL INFORMATION

If more than one screen,
show locations of each on sketch.