

Popal River
G2010

MISSISSIPPI
BOARD OF WATER COMMISSIONERS
416 North State Street
Jackson, Mississippi 39201

8-23-79
8-23 1979
date well completed

WATER WELL DRILLERS LOG

79 Perrell Anderson Popal River
firm name county well located

LANDOWNER:
M.C. Ballard
(mailing address)

WELL LOCATION:
sec 27 T 2 R 15 S 3 W
3 miles E of Poplarville
(distance) (direction) (nearest town)

WELL PURPOSE: HOME
(home, irrigation, municipal, industrial)

WELL COMPLETION DATA:
(1) diameter (inches) 2"
(2) total depth (feet) 105'
(3) static water level (feet) 52 below top of ground.
(4) casing Plastic 100'
(material) (depth)
(size) if telescope see back.
(5) screen 5' 100'
(length) (depth to top)
2" Plastic
(size) (material)
(6) pump 1 18
(HP) (yield gpm)
Elect
(type power)
(7) electric log No
(yes or no)
(organization running log)
(8) how well bottom plugged
Capped

description of formations encountered	from	to
Top Soil	0	1
Clay	1	40
Hard Sand	40	48
Clay	48	78
Coarse Sand	78	105

Miss. Board of Water Comm.


SEP 11 1979

RECEIVED

DRILLERS REMARKS:

If well telescopes please sketch and show depths.

GROUND LEVEL

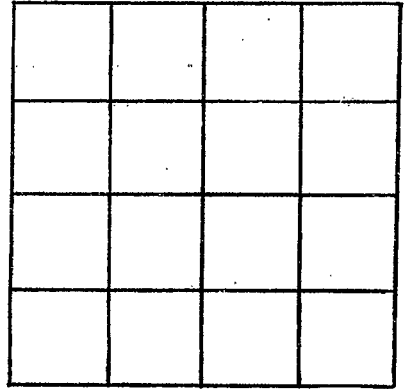

SECTION _____

Please indicate well location X.

ADDITIONAL INFORMATION

If more than one screen,
show locations of each on sketch.