

Pearl River

G 2013

11-7-80

MISSISSIPPI  
 BOARD OF WATER COMMISSIONERS  
 416 North State Street  
 Jackson, Mississippi 39201

WATER WELL DRILLERS LOG

11/7 1980 Red Springs Water Pearl River  
 date well completed Well Service firm name county well located

LANDOWNER: Bonnie Smith

description of formations encountered	from to	
Red Shale	0	60
White Shale	60	240
White Sand	240	270

R.T. 2 Poplarville Miss  
 (mailing address)

WELL LOCATION:  
 sec. 16 T-2 N R-14 E  
 4 miles East of Poplarville  
 (distance) (direction) (nearest town)

WELL PURPOSE: home  
 (home, irrigation, municipal, industrial)

- WELL COMPLETION DATA:
- (1) diameter (inches) 2 1/2
  - (2) total depth (feet) 270
  - (3) static water level (feet) 123 below above top of ground.
  - (4) casing PVC, 260 (material) (depth)
  - (size) if telescope see back.
  - (5) screen 10, 260 (length) (depth to top)  
 12, PVC (size) (material)
  - (6) pump 1HP, 660 gpm (HP) (yield gpm)  
 Elect (type power)
  - (7) electric log no (yes or no)

(organization running log)  
 (8) how well bottom plugged  
 Shale

DRILLERS REMARKS:


DEPT. OF NATURAL RESOURCES  
 BUREAU OF LAND & WATER RESOURCES

NOV 19 1980

RECEIVED

If well telescopes please sketch and show depths.

GROUND LEVEL

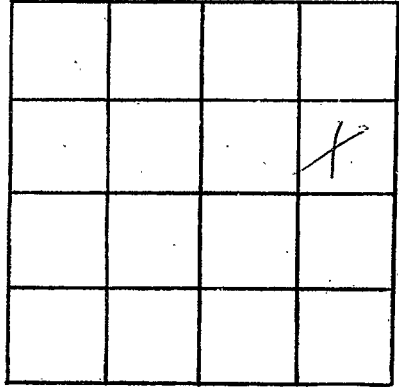

SECTION \_\_\_\_\_

Please indicate well location X.

ADDITIONAL INFORMATION

A series of horizontal lines for writing additional information, starting below the 'ADDITIONAL INFORMATION' header and extending to the bottom of the page.

If more than one screen, show locations of each on sketch.