

Pearl River
 6-2014
 5-14-81

MISSISSIPPI
 BOARD OF WATER COMMISSIONERS
 416 North State Street
 Jackson, Mississippi 39201

WATER WELL DRILLERS LOG

5-14-81 19 date well completed
 BRADEN PUMP AND WELL SERVICE, INC. firm name
 PEARL RIVER county well located

LANDOWNER:
 JAMES CARLISLE
 Rt 2

description of formations encountered

from	to
0	10
10	45

POPLARVILLE, MS
 (mailing address)

Clay
 SAND

WELL LOCATION:
 sec. 27 T 2 N R 15 E
 2 1/2 miles E of Poplarville
 (distance) (direction) (nearest town)

WELL PURPOSE: home
 (home, irrigation, municipal, industrial)

WELL COMPLETION DATA:

(1) diameter (inches) 2"
 (2) total depth (feet) 45'
 (3) static water level (feet) 15 below above top of ground.
 (4) casing PVC, total
 (material) (depth)
 2" if telescope see back.
 (size)
 (5) screen 5' 40'
 (length) (depth to top)
 2" PVC underbar
 (size) (material)
 (6) pump 1 12
 (HP) (yield gpm)
 230
 (type power)
 (7) electric log no
 (yes or no)
 (organization running log)

(8) how well bottom plugged
 2" sand shark

DRILLERS REMARKS:
 no tail pipe


DEPT. OF NATURAL RESOURCES
 BUREAU OF LAND & WATER RESOURCES

JUN 5 - 1981

RECEIVED

If well telescopes please sketch and show depths.

GROUND LEVEL

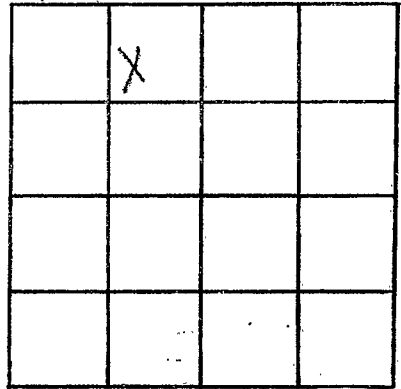

SECTION 27

Please indicate well location X.

ADDITIONAL INFORMATION

If more than one screen,
show locations of each on sketch.