

Pearl River  
G207

MISSISSIPPI  
 BOARD OF WATER COMMISSIONERS  
 416 North State Street  
 Jackson, Mississippi 39201

WATER WELL DRILLERS LOG

12-8 1981 Tom Griffith Pearl River  
 date well completed firm name county well located  
Columbia, 1981


LANDOWNER:	description of formations encountered	from	to
<p><u>Teray Bump</u>  <u>Rt. 1 Box 87 Poplarville</u>            (mailing address)</p>	<p><u>chalk</u>  <u>rock</u> <u>pebbles</u></p>	<p><u>0</u></p>	<p><u>35</u>  <u>35</u> <u>60</u></p>
<b>WELL LOCATION:</b>			
<p>sec. <u>4</u> T. <u>2</u> N: R. <u>5</u> E  <u>10</u> miles <u>N</u> of <u>Poplarville</u>            (distance) (direction) (nearest town)</p>			
<b>WELL PURPOSE:</b>			
<p>(<u>home</u>) irrigation, municipal, industrial</p>			
<b>WELL COMPLETION DATA:</b>			
(1) diameter (inches) <u>6 1/2</u>			
(2) total depth (feet) <u>60</u>			
(3) static water level (feet) <u>50</u> below above top of ground.			
(4) casing <u>0</u> <u>40</u> , (material) (depth)			
(size) if telescope see back.			
(5) screen <u>40</u> <u>60</u> (length) (depth to top)			
<u>10</u> (size) (material)			
(6) pump <u>1/2</u> (HP) (yield gpm)			
(type power)			
(7) electric log <u>yes</u> <u>no</u>			
(organization running log)			
(8) how well bottom plugged <u>sandstone</u>			
DRILLERS REMARKS:			

DEPT. OF NATURAL RESOURCES  
 BUREAU OF LAND & WATER RESOURCES

UN-9 1982  
 RECEIVED

If well telescopes please sketch and show depths.

GROUND LEVEL

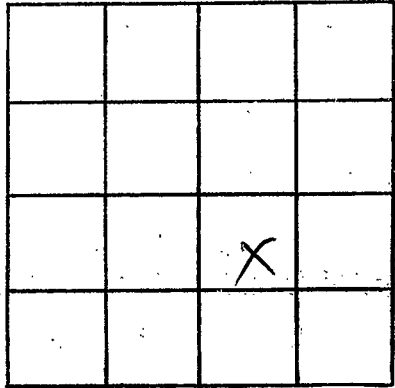

SECTION 4

Please indicate well location X.

ADDITIONAL INFORMATION

If more than one screen, show locations of each on sketch.