

MISSISSIPPI DEPARTMENT OF NATURAL RESOURCES

*Pearl River*  
 G2019

BUD PENTON & SON  
 WATER WELL SERVICE  
 ROUTE 4 BOX 402  
 CARRIERE, MS 39426  
 PHONE 798-5324

Bureau of Land and Water Resources  
 Southport Mall  
 P.O. Box 10631  
 Jackson, Mississippi 39209

WATER WELL DRILLERS LOG

BUD PENTON & SON  
 WATER WELL SERVICE  
 ROUTE BOX  
 CARRIERE, MS 39426  
 PHONE 798-5324

*Pearl River*  
 county well located

3/14 1982  
 date well completed

LANDOWNER: *Thomas G. Wild*  
*51/26 Poplarville*  
*Miss*  
 (mailing address)

| description of formations encountered | from       | to         |
|---------------------------------------|------------|------------|
| <i>white shale</i>                    | <i>132</i> | <i>134</i> |
| <i>white sand</i>                     | <i>132</i> | <i>144</i> |

WELL LOCATION:  
 sec. *27* T. *2* N. R. *15* E.  
*2* miles *E* of *Poplarville*  
 (distance) (direction) (nearest town)

WELL PURPOSE: *home*  
 (home, irrigation, municipal, industrial)

- WELL COMPLETION DATA:
- (1) diameter (inches) *2"*
  - (2) total depth (feet) *144*
  - (3) static water level (feet) *41* below above top of ground.
  - (4) casing *pvc*, *144*  
 (material) (depth)  
 (size) if telescope see back.
  - (5) screen *10ft*, *134*  
 (length) (depth to top)  
*10*, *pvc*  
 (size) (material)
  - (6) pump *1 hp*, *650*  
 (HP) (yield gpm)  
*Elect.*  
 (type power)
  - (7) electric log *no*  
 (yes or no)

(organization running log)

(8) how well bottom plugged *Sand*  
*Shells*

DRILLERS REMARKS:


DEPT. OF NATURAL RESOURCES  
 BUREAU OF LAND & WATER RESOURCES

JUL - 1 1982

RECEIVED

If well telescopes please sketch and show depths.

GROUND LEVEL

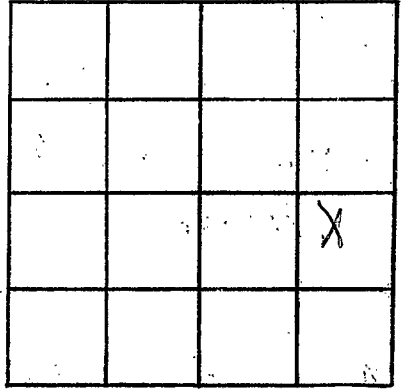

SECTION \_\_\_\_\_

Please indicate well location X.

ADDITIONAL INFORMATION

If more than one screen,  
show locations of each on sketch.