

Paul River
G-2000

MISSISSIPPI DEPARTMENT OF NATURAL RESOURCES
 Bureau of Land and Water Resources
 Southport Mall
 P.O. Box 10631
 Jackson, Mississippi 39209
WATER WELL DRILLERS LOG

9-5-19 Broden Pump Well Sr. Pearl River
 date well completed firm name county well located

LANDOWNER: <u>Red Blake</u>	description of formations encountered	from	to
<u>Box 3, Box 496</u>	<u>Sartory</u>	<u>0</u>	<u>5</u>
<u>Bay St. Louis, Miss. 39520</u> (mailing address)	<u>Red Clay</u>	<u>5</u>	<u>25</u>
WELL LOCATION:	<u>Sand</u>	<u>25</u>	<u>40</u>
sec. <u>5</u> T. <u>2</u> S. R. <u>14</u> W.	<u>White Clay</u>	<u>40</u>	<u>100</u>
<u>6</u> miles <u>S</u> of <u>Lumberton</u>	<u>Blue Clay</u>	<u>120</u>	<u>150</u>
(distance) (direction) (nearest town)	<u>Sand</u>	<u>150</u>	<u>180</u>
WELL PURPOSE: <u>Home</u> (home, irrigation, municipal, industrial)			
WELL COMPLETION DATA:			
(1) diameter (inches) <u>4 1/2</u>			
(2) total depth (feet) <u>180</u>			
(3) static water level (feet) <u>100</u> below above top of ground.			
(4) casing <u>PVC</u> , <u>190</u> (material) (depth)			
<u>4"</u> (size) if telescope see back.			
(5) screen <u>107</u> , <u>170</u> (length) (depth to top)			
<u>2"</u> , <u>PVC</u> (size) (material)			
(6) pump <u>1/2 HP Sub</u> , <u>15</u> (HP) (yield gpm)			
<u>220W 10</u> (type power)			
(7) electric log <u>No</u> (yes or no)			
(organization running log)			
(8) how well bottom plugged <u>2 1/2 inch sand</u>			
DRILLERS REMARKS:			


DEPT. OF NATURAL RESOURCES
 BUREAU OF LAND & WATER RESOURCES

OCT 25 1982

RECEIVED

If well telescopes please sketch and show depths.

GROUND LEVEL

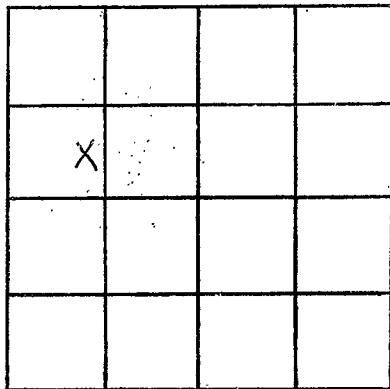

SECTION 5

Please indicate well location X.

ADDITIONAL INFORMATION

If more than one screen,
show locations of each on sketch.