

MISSISSIPPI DEPARTMENT OF NATURAL RESOURCES

Bureau of Land and Water Resources

Southport Mall

P.O. Box 10631

Jackson, Mississippi 39209

WATER WELL DRILLERS LOG

Pearl River
G 2021

11-7-
 date well completed

1982 Braden Pump & Well Ser. Pearl River
 firm name county well located

LANDOWNER:

Mildred Schmalz
Pt. 2, Box 486
La Combe, LA 70445
 (mailing address)

description of formations encountered

from to

| | | |
|--------------------|-----|-----|
| SAND, CLAY, GRAVEL | 0 | 20 |
| CLAY, SAND | 20 | 40 |
| CLAY, SAND | 40 | 60 |
| CLAY, SAND | 60 | 80 |
| SAND | 80 | 100 |
| CLAY, SAND | 100 | 130 |
| CLAY, SAND, CLAY | 130 | 140 |
| CLAY, SAND | 140 | 160 |
| CLAY, SAND | 160 | 180 |
| SAND, CLAY | 180 | 200 |
| CLAY, SAND | 200 | 220 |
| SAND, CLAY | 220 | 240 |
| SAND | 240 | 260 |

WELL LOCATION:

sec. 24 T. 2 R. 15
4 miles E of Poplarville
 (distance) (direction) (nearest town)

WELL PURPOSE: Home
 (home, irrigation, municipal, industrial)

WELL COMPLETION DATA:

- (1) diameter (inches) 2"
- (2) total depth (feet) 260
- (3) static water level (feet) 115 below top of ground.
- (4) casing PVC, 250
 (material) (depth)
— if telescope see back.
 (size)
- (5) screen 10', 250
 (length) (depth to top)
2", PVC Underbar
 (size) (material)
- (6) pump 1HP, 6
 (HP) (yield gpm)
220V 1φ
 (type power)
- (7) electric log NO
 (yes or no)
 (organization running log)

(8) how well bottom plugged 2" pvc sand shock

DRILLERS REMARKS:

Sail Pipe


DEPT. OF NATURAL RESOURCES
 BUREAU OF LAND & WATER RESOURCES

JAN 13 1983

RECEIVED

If well telescopes please sketch and show depths.

GROUND LEVEL

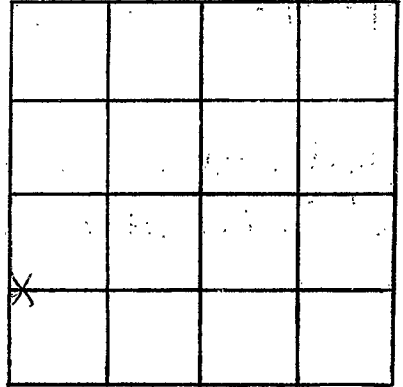

SECTION 24

Please indicate well location X.

ADDITIONAL INFORMATION

If more than one screen, show locations of each on sketch.