

**MISSISSIPPI DEPARTMENT OF NATURAL RESOURCES**  
**Bureau of Land and Water Resources**  
 Southport Mall  
 P.O. Box 10631  
 Jackson, Mississippi 39209  
**WATER WELL DRILLERS LOG**

Pearl River  
G 2022

6-13 1983 POUNCEY WATER WELL DRILLING Pearl River  
 date well completed firm name county well located

LANDOWNER:	description of formations encountered	from	to
<u>Dr. H. H. Harris</u>			
<u>Rt. Poplarville -</u>	<u>TOP</u>	<u>0</u>	<u>12</u>
<u>Hy 26 Harris - Clinic</u> (mailing address)	<u>sd</u>	<u>12</u>	<u>26</u>
<b>WELL LOCATION:</b>			
sec. <u>27</u> T <u>2</u> N R <u>15</u> E <u>3</u> miles <u>E</u> of <u>Poplarville</u> (distance) (direction) (nearest town)	<u>HD HD HD Clay</u>	<u>26</u>	<u>56</u>
	<u>sd -</u>	<u>56</u>	<u>128</u>
<b>WELL PURPOSE:</b> <u>Home &amp; Clinic</u> (home, irrigation, municipal, industrial)			
<b>WELL COMPLETION DATA:</b>			
(1) diameter (inches) <u>4</u>			
(2) total depth (feet) <u>128</u>			
(3) static water level (feet) <u>55</u> below top of ground.			
(4) casing <u>PVC</u> <u>118</u> (material) (depth) <u>4</u> (size) if telescope see back.			
(5) screen <u>10</u> <u>118</u> (length) (depth to top) <u>4</u> (size) <u>PVC</u> (material)			
(6) pump <u>1/2</u> <u>16</u> (HP) (yield gpm) <u>AC</u> (type power)			
(7) electric log <u>/</u> (yes or no) <u>/</u> (organization running log)			
(8) how well bottom plugged <u>Sealed</u>			
<b>DRILLERS REMARKS:</b> <u>Pumps surge at 90' set 100' pumped 16 gpm</u>			


DEPT. OF NATURAL RESOURCES  
 BUREAU OF LAND & WATER RESOURCES

AUG 26 1983

**RECEIVED**

If well telescopes please sketch and show depths.

GROUND LEVEL

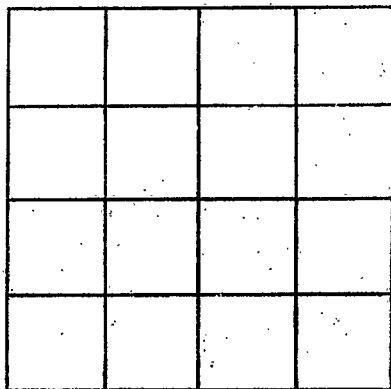

SECTION \_\_\_\_\_

Please indicate well location X.

ADDITIONAL INFORMATION

If more than one screen, show locations of each on sketch.