

MISSISSIPPI DEPARTMENT OF NATURAL RESOURCES

Bureau of Land and Water Resources

Southport Mall

P.O. Box 10631

BUD PENNINGTON, Mississippi 39209

WATER WELL DRILLERS LOG

Rt. 4, Box 402

Carriere, Mississippi 39426

Phone 601-798-5374

Lead River  
G 2023  
5/24/85

5704

1985

date well completed

Lead River

county well located

LANDOWNER: Rayn Barnes  
PO Box 283 Poplarville  
Miss 39470  
(mailing address)

description of formations encountered

from

to

White Shell  
White Sand

0 70  
70 190

WELL LOCATION:

sec 27 T 2 N 3 R 5 E W  
4 miles E of Poplarville  
(distance) (direction) (nearest town)

WELL PURPOSE: home  
(home, irrigation, municipal, industrial)

WELL COMPLETION DATA:

- (1) diameter (inches) 4"
- (2) total depth (feet) 190
- (3) static water level (feet) 44 below above top of ground.
- (4) casing PVC, 190,  
(material) (depth)  
20 if telescope see back.  
(size)
- (5) screen 10 ft, 190  
(length) (depth to top)  
12, PVC  
(size) (material)
- (6) pump 1 1400 23 gpm  
(HP) (yield gpm)  
Elect.  
(type power)
- (7) electric log no  
(yes or no)

(organization running log)

(8) how well bottom plugged shard

DRILLERS REMARKS:


RECEIVED

JUN - 6 1985

Department of Natural Resources  
Bureau of Land & Water Resources

If well telescopes please sketch and show depths.

GROUND LEVEL

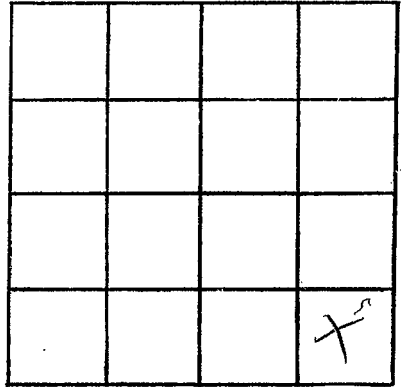

SECTION \_\_\_\_\_

Please indicate well location X.

ADDITIONAL INFORMATION

If more than one screen,  
show locations of each on sketch.