

MISSISSIPPI DEPARTMENT OF NATURAL RESOURCES

Bureau of Land and Water Resources

Southport Mall

P.O. Box 10631

Jackson, Mississippi 39209

WATER WELL DRILLERS LOG

PEARL RIVER
G 2004
8/20/85

8-20 1985 PENTON WELL SERV PEARL RIVER
date well completed firm name county well located

LANDOWNER: AL LUMPKINS
POPLARVILLE, MS.

(mailing address)

WELL LOCATION:

sec. 35 T. 2 R. 15 S. W.
6 miles E of Poplarville
(distance) (direction) (nearest town)

WELL PURPOSE: HOME
(home, irrigation, municipal, industrial)

WELL COMPLETION DATA:

- (1) diameter (inches) 2"
- (2) total depth (feet) 230'
- (3) static water level (feet) 48' below top of ground.
- (4) casing PVC, 220' (material) (depth)
2 (size) if telescope see back.
- (5) screen 10', 220' (length) (depth to top)
2 PVC (size) (material)
- (6) pump 1 (HP) (yield gpm)
Elec (type power)
- (7) electric log NO (yes or no)

(organization running log)

(8) how well bottom plugged B.W.

description of formations encountered	from	to
CLAY	0	90
SAND	90	120
CLAY	120	180
SAND	180	230

RECEIVED


SEP - 9 1985

Department of Natural Resources
Bureau of Land & Water Resources

DRILLERS REMARKS:

If well telescopes please sketch and show depths.

GROUND LEVEL

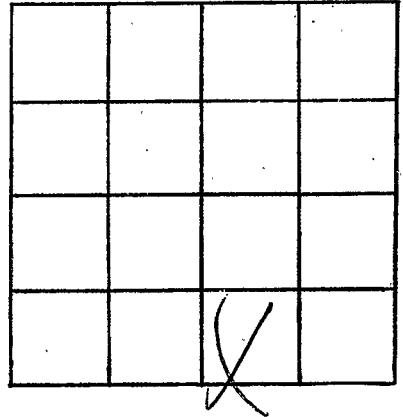

SECTION _____

Please indicate well location X.

ADDITIONAL INFORMATION

If more than one screen, show locations of each on sketch.