

MISSISSIPPI DEPARTMENT OF NATURAL RESOURCES

Bureau of Land and Water Resources

Southport Mall

P.O. Box 10631

Jackson, Mississippi 39209

WATER WELL DRILLERS LOG

Pearl River
Grain

5-3

date well completed

1986 Parnell Anderson Pearl River

firm name

county well located

LANDOWNER: Clint Lee

Poplarville Miss

(mailing address)

WELL LOCATION:

sec 27 T 2 S R 15 W

4 miles E of Poplarville
(distance) (direction) (nearest town)

WELL PURPOSE: Home
(home, irrigation, municipal, industrial)

WELL COMPLETION DATA:

- (1) diameter (inches) 2
- (2) total depth (feet) 148
- (3) static water level (feet) 60 below above top of ground.
- (4) casing PVC, 138,
(material) (depth)
2 if telescope see back.
(size)
- (5) screen 10, 138
(length) (depth to top)
3, PVC
(size) (material)
- (6) pump 1 8
(HP) (yield gpm)
Electric
(type power)
- (7) electric log NO
(yes or no)

(organization running log)

(8) how well bottom plugged Cap

description of formations encountered

from

to

Top Soil	0	2
Clay	2	18
Sand	18	23
Blue Clay	23	121
Sand	121	148

RECEIVED


JUN 12 1986

Department of Natural Resources
Bureau of Land & Water Resources

DRILLERS REMARKS:

If well telescopes please sketch and show depths.

GROUND LEVEL

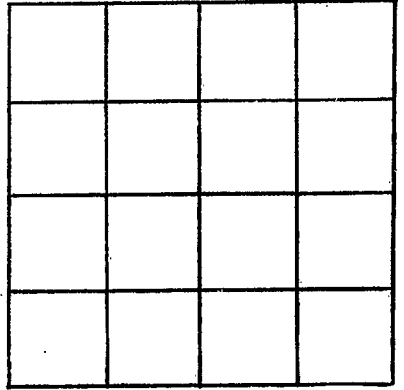

SECTION _____

Please indicate well location X.

ADDITIONAL INFORMATION

If more than one screen,
show locations of each on sketch.