

P. Raven
G-2030

MISSISSIPPI DEPARTMENT OF NATURAL RESOURCES
Bureau of Land and Water Resources
Southport Mall
P.O. Box 10631
Jackson, Mississippi 39209
WATER WELL DRILLERS LOG

5/22/88 1988 Bud Perton & Son Pearl River
date well completed firm name county well located

LANDOWNER: Mr. Elmorsan
BX 163D RT3
Lumberton Miss.
(mailing address)

description of formations encountered		from	to
<u>Red shell</u>		<u>0</u>	<u>21</u>
<u>Red sand</u>		<u>21</u>	<u>35</u>
<u>Red shell</u>		<u>35</u>	<u>42</u>
<u>Red sand</u>		<u>42</u>	<u>5-2</u>

WELL LOCATION:
sec. 2 T. 2 N R. 15 E
10 miles East pearl river
(distance) (direction) (nearest town)

WELL PURPOSE: home
(home, irrigation, municipal, industrial)

WELL COMPLETION DATA:

- (1) diameter (inches) 4"
- (2) total depth (feet) 5-2
- (3) static water level (feet) 24 below above top of ground.
- (4) casing pvc, 42,
(material) (depth)
_____ if telescope see back.
(size)
- (5) screen 10, 42
(length) (depth to top)
12, pvc
(size) (material)
- (6) pump 1, 18
(HP) (yield gpm)
Elect
(type power)
- (7) electric log no
(yes or no)

(organization running log)

(8) how well bottom plugged Sand
shark

DRILLERS REMARKS: gravel
rock


RECEIVED
MAY 25 1988

JUN 16 1988

Department of Natural Resources
Bureau of Land & Water Resources

If well telescopes please sketch and show depths.

GROUND LEVEL

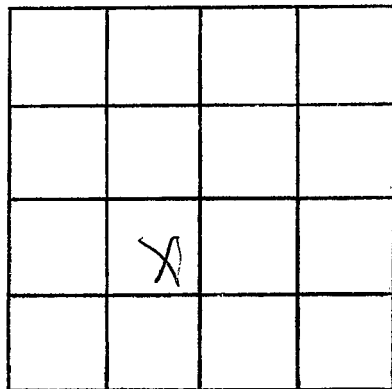

SECTION _____

Please indicate well location X.

ADDITIONAL INFORMATION

If more than one screen,
show locations of each on sketch.