

MISSISSIPPI DEPARTMENT OF NATURAL RESOURCES

Bureau of Land and Water Resources

Southport Mall

P.O. Box 10631

Jackson, Mississippi 39209

WATER WELL DRILLERS LOG

P. ROEL
G-2231

11/7/89 date well completed 1989 Bud Ponton & Son firm name Pearl River county well located

LANDOWNER: Lewis Hass
RT 5 Box 146 Poplarville
39470 (mailing address)


description of formations encountered	from	to
Red shale	0	20
Red sand	20	30
Blue shale	30	230
Gray sand	230	250

WELL LOCATION:
sec. 18 T-2 N R-15 E
4 miles North Poplarville (distance) (direction) (nearest town)

WELL PURPOSE: home (home, irrigation, municipal, industrial)

WELL COMPLETION DATA:

- (1) diameter (inches) 4
- (2) total depth (feet) 250
- (3) static water level (feet) 138 below top of ground.
- (4) casing PVC, 250 (material) (depth)
- 4x2 (size) if telescope see back.
- (5) screen 10 (length) 240 (depth to top)
- 12 (size) (material)
- (6) pump 1 (HP) 10 (yield gpm)
- Elect (type power)
- (7) electric log Yes (yes or no)

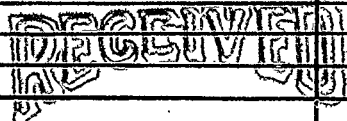

JAN 3 1990


Department of Natural Resources
Bureau of Land & Water Resources

(organization running log)
(8) how well bottom plugged Sand

DRILLERS REMARKS:

If well telescopes please sketch and show depths.

GROUND LEVEL

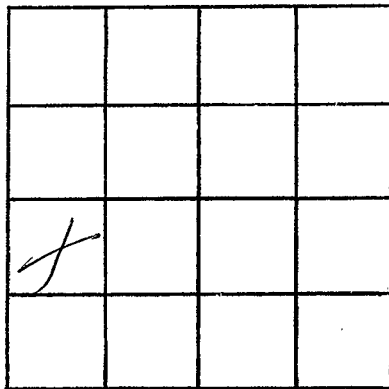

SECTION _____

Please indicate well location X.

ADDITIONAL INFORMATION

If more than one screen,
show locations of each on sketch.