

MISSISSIPPI DEPARTMENT OF NATURAL RESOURCES

Bureau of Land and Water Resources

Southport Mall

P.O. Box 10631

Jackson, Mississippi 39209

WATER WELL DRILLERS LOG

P. River
 CT 2034

11/5
 date well completed

1990 Red Penton
 firm name

Jasper River
 county well located


LANDOWNER: Edd Lee
Box 26 Poplarville
Miss
 (mailing address)

description of formations encountered	from	to
Red shale	0	10
Red gravel	10	15
White sand	15	140
White sand	140	168

WELL LOCATION:
 sec. 27 T. 2 N. R. 15 E.
4 miles East of Poplarville
 (distance) (direction) (nearest town)

WELL PURPOSE: home
 (home, irrigation, municipal, industrial)

- WELL COMPLETION DATA:
- (1) diameter (inches) 2
 - (2) total depth (feet) 168
 - (3) static water level (feet) 102 ~~above~~ below top of ground.
 - (4) casing pvc 168
 (material) (depth)
 (size) if telescope see back.
 - (5) screen 10 15-8
 (length) (depth to top)
12 pvc
 (size) (material)
 - (6) pump no
 (HP) (yield gpm)
 (type power)
 - (7) electric log no
 (yes or no)
 (organization running log)
 - (8) how well bottom plugged estand
stand

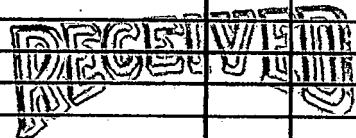


FEB 19 1991

Dept. of Environmental Quality
 Bureau of Land & Water Resources

DRILLERS REMARKS:

If well telescopes please sketch and show depths.

GROUND LEVEL

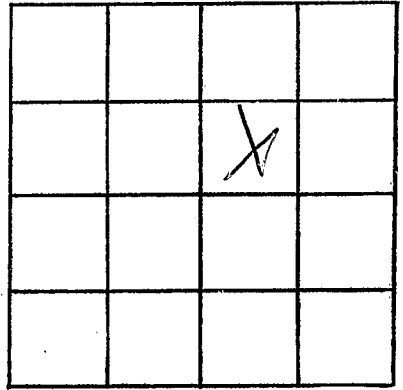

SECTION _____

Please indicate well location X.

ADDITIONAL INFORMATION

If more than one screen, show locations of each on sketch.
