

MISSISSIPPI DEPARTMENT OF ENVIRONMENTAL QUALITY

Office of Land and Water Resources

P. O. Box 10631
Jackson, MS 39289-0631
WATER WELL DRILLERS LOG

COUNTY WELL LOCATED Pearl River	
WELL NUMBER 2043	CODED
DATE WELL COMPLETED 8-8-94	

PERMIT NUMBER
NAME OF DRILLING FIRM BOONE Water Well

NAME & MAILING ADDRESS OF LANDOWNER Frank Harrison			
WELL LOCATION: SEC <u>34</u> TOWNSHIP <u>Z</u> RANGE <u>15</u>			
DISTANCE <u>3</u> Miles DIRECTION <u>E</u> of NEAREST TOWN <u>Poplarville</u>			
OTHER LANDMARK			
WELL PURPOSE <u>Home</u> Irrigation, Municipal, Industrial, Fish Pond, etc.			

PUMP DATA		
PUMP TYPE (Circle One): Submersible, Turbine, Jet, Flowing Well, Other (Describe) _____		
POWER TYPE (Circle One): Electric, Tractor, Diesal, Gasoline, Butane, Other (Describe) _____ H/P _____		
Pump Capacity (GPM)	No. of Stages	Setting Depth FT.
PUMP TEST		
Well yielded _____ GPM with a drawdown of _____ ft. after _____ hours of pumping		

WELL DATA		
Well Depth 160	Casing Diameter (In.) 2	Casing Length (Ft.) 150
Type of Casing sch 40	Hole Depth 160	Depth to Static Water Level
TYPE OF COMPLETION: (Circle One or More): <u>Gravel Packed</u> , Underreamed, Telescoped, Natural Development, Open Hole, Other (Describe) _____		
WELL GROUTED TO A DEPTH OF <u>5</u> FEET Type Grout (circle one): <u>Cement</u> , Bentonite, or Mix		

LOG DATA	
TYPE OF LOG RUN (Circle One): Electric, Gamma Ray, Density, Sonic, Neutron, Other (Describe) _____	
Name of Organization Running Log	

SCREEN DATA		
Diameter - Inches 2	Length - Feet 10	Slot Size - Inches 8
Screen Type sch 40	Depth to Bottom - Feet	

GEOLOGIC DATA (Office Use Only)			
Surface Elev.	Geologic Unit	Unit Thickness	Depth to Top
Subs. SWL	Date	Analysis	Aquifer Test
Driller's Remarks Drill + set casing only			


DESCRIPTION OF FORMATIONS ENCOUNTERED	FROM	TO
Clay	0	120
Sand	120	160

FORMATIONS (Continued)	FROM	TO
RECEIVED		
NOV 14 1994		
Dept. of Environmental Quality Office of Land & Water Resources		

IF MORE SPACE IS NEEDED, USE BACK

If well telescopes please
sketch and show depths.

GROUND LEVEL

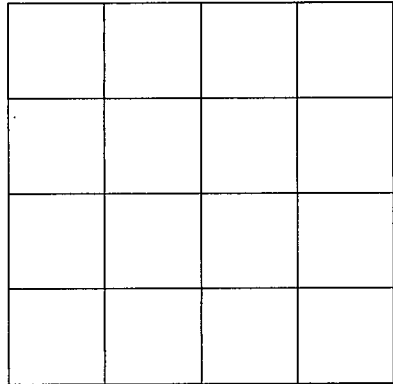

SECTION _____

Please indicate well location X.

ADDITIONAL INFORMATION

If more than one screen,
show location of each on sketch.