

MISSISSIPPI DEPARTMENT OF ENVIRONMENTAL QUALITY

QUALITY

Office of Land and Water Resources

P. O. Box 10631

Jackson, MS 39289-0631

WATER WELL DRILLERS LOG

COUNTY WELL LOCATED Pearl River	
WELL NUMBER G-2047	CODED
DATE WELL COMPLETED 8-7-99	

PERMIT NUMBER 0-514
NAME OF DRILLING FIRM Booneswater Well

NAME & MAILING ADDRESS OF LANDOWNER Dale Watson 11 L.C. Davis Rd Poplarville, Ms			
WELL LOCATION:	SEC 25	TOWNSHIP 2	RANGE N 15 E
DISTANCE 6 Miles	DIRECTION East	NEAREST TOWN Poplarville	
OTHER LANDMARK			
WELL PURPOSE: <input checked="" type="radio"/> Home Irrigation, <input type="radio"/> Municipal, <input type="radio"/> Industrial, <input type="radio"/> Fish Pond, etc.			

PUMP DATA		
PUMP TYPE (Circle One): <input checked="" type="radio"/> Submersible, <input type="radio"/> Turbine, <input type="radio"/> Jet <input type="radio"/> Flowing Well, Other (Describe) _____		
POWER TYPE (Circle One): <input checked="" type="radio"/> Electric, <input type="radio"/> Tractor, <input type="radio"/> Diesel, <input type="radio"/> Gasoline, <input type="radio"/> Butane, Other (Describe) _____ H/P 1		
Pump Capacity (GPM) 20	No. of Stages	Setting Depth _____ FT.
PUMP TEST		
Well yielded _____ GPM with a drawdown of _____ ft. after _____ hours of pumping		

WELL DATA		
Well Depth 260	Casing Diameter (In.) 4	Casing Length (Ft.) 240
Type of Casing sch 40	Hole Depth 260	Depth to Static Water Level 140
TYPE OF COMPLETION: (Circle One or More): <input checked="" type="radio"/> Gravel Packed, <input type="radio"/> Underreamed, <input type="radio"/> Telescoped, <input type="radio"/> Natural Development, <input type="radio"/> Open Hole, <input type="radio"/> Other (Describe) _____		

LOG DATA	
TYPE OF LOG RUN (Circle One): <input type="radio"/> No Log Run, <input type="radio"/> Electric, <input type="radio"/> Gamma Ray, <input type="radio"/> Density, <input type="radio"/> Sonic, <input type="radio"/> Neutron, Other (Describe) _____	
Name of Organization Running Log	


WELL GROUTED TO A DEPTH OF 5 FEET
Type Grout (circle one): Cement, Bentonite, or Mix

GEOLOGIC DATA (Office Use Only)			
Surface Elev.	Geologic Unit	Unit Thickness	Depth to Top
Subs. SWL	Date	Analysis	Aquifer Test

SCREEN DATA		
Diameter - Inches	Length - Feet	Slot Size - Inches
Screen Type		Depth to Bottom - Feet


Driller's Remarks
Top of Lap Pipe or Reduction in Casing
IF TELESCOPED OR MORE THAN ONE SCREEN, USE BACK PAGE

DESCRIPTION OF FORMATIONS ENCOUNTERED	FROM	TO
Sand	0	35
Clay	35	200
Sand	200	260

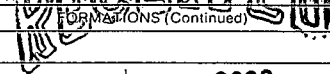 DEPARTMENT OF ENVIRONMENTAL QUALITY STATE OF MISSISSIPPI	
JUL 27 2000	
Dept. of Environmental Quality Office of Land & Water Resources	
IF MORE SPACE IS NEEDED, USE BACK	

If well telescopes please
sketch and show depths.

GROUND LEVEL

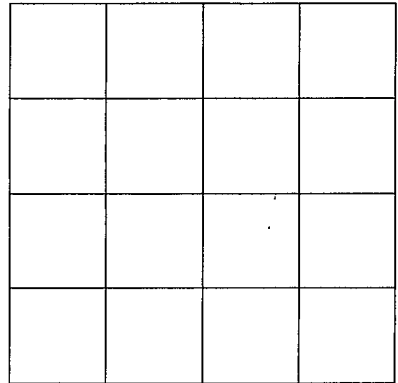

SECTION _____

Please indicate well location X.

ADDITIONAL INFORMATION

If more than one screen,
show location of each on sketch.